

Desoto
 AF 50
 11-12-64

MISSISSIPPI BOARD OF WATER COMMISSIONERS

CODED

WATER WELL DRILLERS LOG

Date: Nov. 12, 19 64, Driller: Deep South Well Co. County Desoto
 (Name)

(1) Owner of Land	Description & Color of Materials Sand, Clay, Red Clay, Shell, etc.	Thick- ness Feet	Depth Feet
<u>Mrs. W. F. Turman</u> (Name)	<u>0 - 15 Surface clay</u>	<u>15</u>	
<u>Rt. 1, Nesbit, Miss.</u> (Address)	<u>15 - 45 Sand & gravel</u>	<u>30</u>	
(2) Location: <u>1/4</u> , <u>12</u> <u>1/4</u> , Sec. <u>T 2 R 2</u>	<u>45 - 80 Yellow Clay</u>	<u>35</u>	
<u>3</u> miles <u>S. E.</u> , of <u>Horn Lake</u> (distance) (direction) (Nearest Town)	<u>80 - 160 Blue Clay</u>	<u>80</u>	
(3) Topography: <u>Level</u> (Hilly) (Flat) (Level)	<u>160 - 210 Fine Sand</u>	<u>50</u>	
(4) Purpose of Well: <u>Domestic</u> (Domestic Irrigation Municipal, Industrial, Other)	<u>210 - 218 Med Fine Sand</u>	<u>8</u>	
	<u>218 - 231 Med. Coarse</u>		
	<u>W/ some coarse sand</u>	<u>13</u>	

Information upon completion of well:


- (1) Diameter 2 1/2 inches.
- (2) Total Depth 231 feet.
- (3) Water Level 123 feet below top of ground.
- (4) Cased to 224, Size 2 1/2"
- (5) Screen: Size 1 1/2", Length 8 ft.
- (6) Were any formations sealed against pollution?
no yes, X no.

If YES depth of formation _____

Why _____

Drillers Remarks: _____

CODED

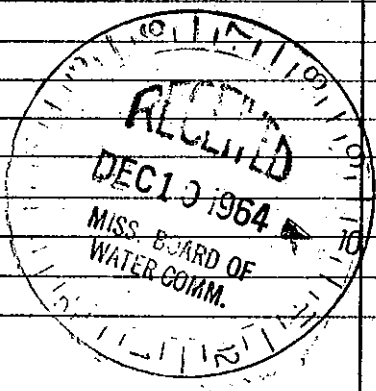

(Use Back Side)

Well No.

Mail this copy to Board of Water Commissioners 429 Miss. St. Jackson, Miss.