

DeSoto

MISSISSIPPI BOARD OF WATER COMMISSIONERS

BF 51

6-23-63

WATER WELL DRILLERS LOG

CODED ²

Date: 6/23, 19 63, Driller: Deep South Well Co. County DeSoto

(Name)

(1) Owner of Land: Mrs. W. F. Turman
(Name)

Hwy. 51, So. at Church Rd., Horn
(Address) Lake, Miss.

(2) Location: 1/4, 1/4, Sec. 11, T. 2 R. 8

2 miles S.E. of Horn Lake,
(distance) (direction) (Nearest Town)

(3) Topography: Flat
(Hilly) (Flat) (Level)

(4) Purpose of Well: Domestic
(Domestic Irrigation
Municipal, Industrial, Other)

Information upon completion of well:

(1) Diameter 4 inches.

(2) Total Depth 454 feet.

(3) Water Level 128 feet below top of ground.

(4) Cased to None, Size None

(5) Screen: Size 2 1/8", Length 19 ft

(6) Were any formations sealed against pollution?


yes, No no.

If YES depth of formation

Why

Drillers Remarks:

Description & Color of Materials Sand, Clay, Red Clay, Shell, etc.	Thick- ness Feet	Depth Feet
0-38 Surface clay	38	
38-77 Sand & Gravel	39	
77-149 Blue clay	72	
149-267 Fine sand	118	
267-277 Med. sand, some med. coarse	10	
277-278 Soft rock	1	
278-293 Yellow clay	15	
293-294 Soft rock	1	
294-340 Fine sand	46	
340-363 Med. fine sand	23	
363-371 Med. coarse, clay streaks	8	
371-410 Fine sand	39	
410-430 Med. coarse, some coarse	20	
430-454 Coarse & med. coarse sand	24	

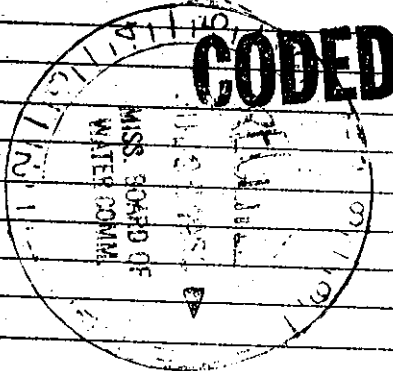

Well No.

(Use Back Side)

Mail this copy to Board of Water Commissioners 429 Miss. St. Jackson, Miss.