

DeSoto MISSISSIPPI BOARD OF WATER COMMISSIONERS

BF54
5-18-63

WATER WELL DRILLERS LOG **CODED**

Date: 5/18, 1963, Driller: Deep South Well Co. County DeSoto
(Name)

	Description & Color of Materials Sand, Clay, Red Clay, Shell, etc.	Thick- ness Feet	Depth Feet
(1) Owner of Land: <u>O. E. Scott</u> (Name) <u>Horn Lake, Miss.</u> (Address)	0-25 Surface clay	25	
(2) Location: <u>1/4</u> , <u>1/4</u> , Sec. <u>4 T 2 R 8</u> , <u>2 1/2</u> miles <u>S.W.</u> of <u>Horn Lake</u> . (distance) (direction) (Nearest Town)	25-50 Mucky sand, some	25	
(3) Topography: <u>Hilly</u> (Hilly) (Flat) (Level)	50-65 Fine sand gravel	15	
(4) Purpose of Well: <u>Domestic</u> (Domestic Irrigation Municipal, Industrial, Other)	65-89 Yellow clay	24	
	89-150 Blue clay	61	
	150-194 Blue clay, strks fine sand	44	
	194-202 Med. fine sand & clay strks	8	
	202-209 Coarse sand	7	


Information upon completion of well:

- (1) Diameter 2 inches.
- (2) Total Depth 209 feet.
- (3) Water Level 78 feet below top of ground.
- (4) Cased to None, Size _____
- (5) Screen: Size 1 1/4", Length 5 ft
- (6) Were any formations sealed against pollution?
_____ yes, No no.

If YES depth of formation _____

Why _____

Drillers Remarks: _____

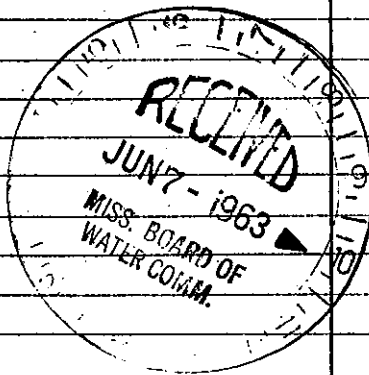

(Use Back Side)

Well No.

Mail this copy to Board of Water Commissioners 429 Miss. St. Jackson, Miss.