

DESOTO

WATER WELL DRILLERS LOG


F55

Date: 7-10-1963 Driller: CODED Perry County Desota
7-10-63

(1) Owner of Land	Description & Color of Materials Sand, Clay, Red Clay, Shell, etc.	Thick- ness Feet	Depth Feet
John Gartrell (Name)	0-7 Clay		
Lake Carmichael (Address)	20-40 gravel		
Star Landing Rd 1/2 mile (Location)	40-136 soft shales		
East of Hwy 301 1/4, Sec. 2 T. 2 R. 8 (Location)	136-156 sandy shales		
4 miles (distance)	156-172 shale		
S of Hwy 301 (direction)	172-173 Rock		
3 1/2 miles (distance)	173-190 soft clay		
of Hamlet (Nearest Town)	190-190-6" Rock		
(4) Purpose of Well: Domestic (Domestic Irrigation Municipal, Industrial, Other)	190-6"-223 soft clay		
	223-223-4" Rock		
	223-4"-259 soft clay		
	259-259-6" Rock		
	259-6"-274 sand		

Information upon completion of well:

- (1) Diameter 2 inches.
- (2) Total Depth 274 feet.
- (3) Water Level 50 feet below top of ground.
- (4) Cased to 274, Size 2
- (5) Screen: Size 1 1/4, Length 4'
- (6) Were any formations sealed against pollution?
 yes, no.

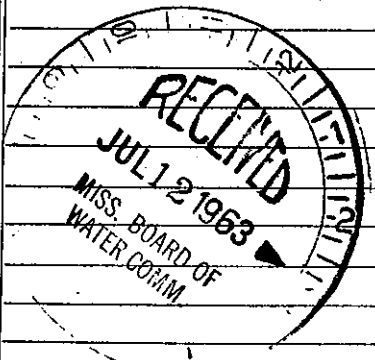

If YES depth of formation _____
 Why clay puddled from surface
 Drillers Remarks:

did not drill to bottom of sand

Well No.

(Use Back Side)

Retain this copy for your office files.