

DESOTO MISSISSIPPI BOARD OF WATER COMMISSIONERS

F 57
4-15-62

WATER WELL DRILLERS LOG

CODED


Date: 4-15-62, Driller: C. B. Perry County Desoto
(Name)

| (1) Owner of Land: | Description & Color of Materials Sand, Clay, Red Clay, Shell, etc. | Thick- ness Feet | Depth Feet |
|--|---|------------------------|---------------|
| James O Clark (Name) 2000 ft So of Church Rd on Farm Rd (Address) | 0-20 ft Clay | | |
| (2) Location: 1/4, 1/4, Sec. 8 T2R2 | 20-35 Clay & gravel | | |
| 3 miles S. W. of Homestead (distance) (direction) (Nearest Town) | 35-47 white Clay | | |
| (3) Topography: <u>Hilly</u> (Hilly) (Flat) (Level) | 47-127 Black shale | | |
| (4) Purpose of Well: <u>Dam</u> (Domestic Irrigation Municipal, Industrial, Other) | (Shale) 127-211 Green | | |
| | shale 211-218 very | | |
| | fine sand 218-272 | | |
| | Green shale | | |
| | 272-320 fine sand | | |
| | 320-329 coarse | | |
| | white water sand | | |

Information upon completion of well:

- (1) Diameter 2 1/2 inches.
- (2) Total Depth 329 feet.
- (3) Water Level 90 feet below top of ground.
- (4) Cased to 326, Size 2 1/2.
- (5) Screen: Size 1 1/2, Length 6'.
- (6) Were any formations sealed against pollution?
✓ yes, no.

CODED

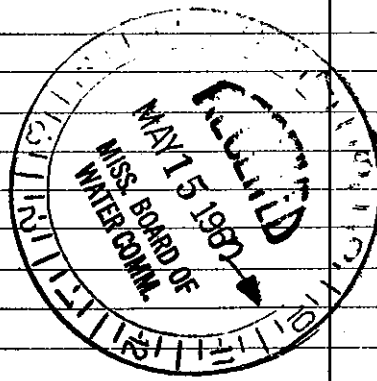

If YES depth of formation Clay Riddled
from surface
Why General practice
Drillers Remarks: at 329'-1"

hit yellow sand
stopped before
getting into it

Well No.

(Use Back Side)