

Desoto MISSISSIPPI BOARD OF WATER COMMISSIONERS

BF 58

2-28-66

WATER WELL DRILLERS LOG

CODED

Date: FEB 28, 1966, Driller: MILLER

County DESOTO

(Name)

(1) Owner of Land: <u>EDWARD BAILEY</u>	Description & Color of Materials Sand, Clay, Red Clay, Shell, etc.	Thick- ness Feet	Depth Feet
(Name)	<u>0-25" SURFACE CLAY</u>	<u>25</u>	
RTE #1 <u>NESBIT, MISS.</u> (Address)	<u>25-46 SAND & GRAVEL</u>	<u>21</u>	
(2) Location: <u>1/4, 1/4, Sec. 9 T. 2R. 8.</u>	<u>46-235" BLUE CLAY</u>	<u>189</u>	
<u>2</u> miles <u>S.E.</u> of <u>HORN LAKE</u> (distance) (direction) (Nearest Town)	<u>235-259 MED. COARSE SAND</u>	<u>24</u>	
(3) Topography: <u>HILLY</u> (Hilly) (Flat) (Level)			
(4) Purpose of Well: <u>DOMESTIC</u> (Domestic Irrigation Municipal, Industrial, Other)			

Information upon completion of well:


CODED

- (1) Diameter 2 1/2 inches.
- (2) Total Depth 259 feet.
- (3) Water Level 120 feet below top of ground.
- (4) Cased to 252, Size 2 1/2.
- (5) Screen: Size 1 1/2", Length 7'.
- (6) Were any formations sealed against pollution?
no.

If YES depth of formation _____

Why _____

Drillers Remarks: _____

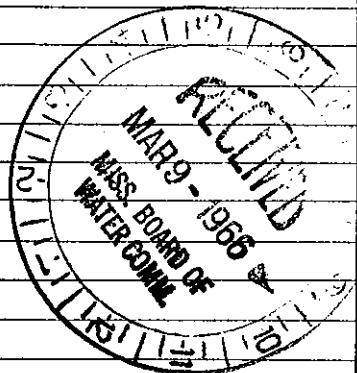

Well No. _____

(Use Back Side)

Mail this copy to Board of Water Commissioners 429 Miss. St. Jackson, Miss.