

DeSoto  
 BF 59  
 2-13-61

WATER WELL DRILLERS LOG **CODED** 303


Date: Feb. 13, 19 61, Driller: Deep South Well Co. County DeSoto  
 (Name)

(1) Owner of Land: <u>W. H. Ross</u> (Name)	Description & Color of Materials Sand, Clay, Red Clay, Shell, etc.	Thick- ness Feet	Depth Feet
<u>Horn Lake, Miss.</u> (Address)	<u>0-31 Surface clay</u>	<u>31</u>	
(2) Location: <u>1/4, 1/4, Sec. 17, T. 2 R. 8</u> <u>1 1/8</u> miles <u>S.E.</u> of <u>Horn Lake</u> (distance) (direction) (Nearest Town)	<u>31-61 Red sand, clay stks</u>	<u>30</u>	
(3) Topography: <u>Flat</u> (Hilly) (Flat) (Level)	<u>61-85 Yellow clay</u>	<u>24</u>	
(4) Purpose of Well: <u>Domestic</u> (Domestic Irrigation Municipal, Industrial, Other)	<u>85-150 Blue sandy clay</u>	<u>65</u>	
	<u>150-208 Fine sand, clay stks</u>	<u>58</u>	
	<u>208-214 Med. Sand</u>	<u>6</u>	
	<u>214-235 Med. coarse sand</u>	<u>21</u>	

Information upon completion of well:

- (1) Diameter 3 inches.
- (2) Total Depth 235 feet.
- (3) Water Level 122 feet below top of ground.
- (4) Cased to \_\_\_\_\_, Size \_\_\_\_\_.
- (5) Screen: Size 2", Length 8'.
- (6) Were any formations sealed against pollution?  
 \_\_\_\_\_ yes, X no.

If YES depth of formation \_\_\_\_\_  
 Why \_\_\_\_\_  
 Drillers Remarks: \_\_\_\_\_

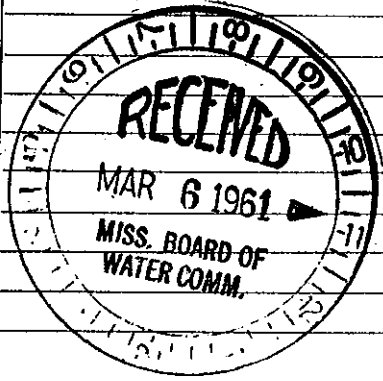

(Use Back Side)

Well No.