

DESOTO MISSISSIPPI BOARD OF WATER COMMISSIONERS

F 60
5-16-65

WATER WELL DRILLERS LOG

CODED

Date: 5-16-, 1965, Driller: C. B. PERRY County DESOTA
(Name)

(1) Owner of Land	Description & Color of Materials Sand, Clay, Red Clay, Shell, etc.	Thick- ness Feet	Depth Feet
<u>JOHN SHEPHERD</u> (Name) <u>DAYS MISS</u> (Address)	<u>0-40 1/2 Clay</u> <u>40-160 gumbo</u> <u>160-220 fine sand</u> <u>220-231 med coarse sand</u>		
(2) Location: <u>1/4</u> , <u>1/4</u> , Sec. <u>17 T 38 R 8</u> <u>1</u> miles <u>EAST</u> , of <u>DAYS</u> (distance) (direction) (Nearest Town)			
(3) Topography: <u>X</u> (Hilly) (Flat) (Level)			
(4) Purpose of Well: <u>DOMESTIC</u> (Domestic Irrigation Municipal, Industrial, Other)			

CODED


Information upon completion of well:

- (1) Diameter 3 inches.
- (2) Total Depth 231 feet.
- (3) Water Level 106 feet below top of ground.
- (4) Cased to 227, Size 3
- (5) Screen: Size 2 1/2", Length 4'
- (6) Were any formations sealed against pollution?
X yes, _____ no.

If YES depth of formation _____

Why CLAY PUDDLED SURFACE FROM GENERAL PRACTICE

Drillers Remarks: _____

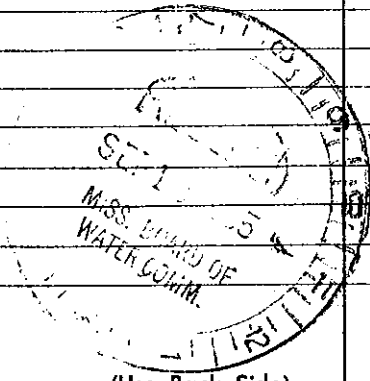

(Use Back Side)

Well No. _____

Mail this copy to Board of Water Commissioners 429 Miss. St. Jackson, Mis