

DeSoto MISSISSIPPI BOARD OF WATER COMMISSIONERS

F 61
2-15-64

WATER WELL DRILLERS LOG

CODED

Date: Feb. 15, 1964, Driller: Deep South Well Co. County DeSoto
(Name)

(1) Owner of Land: <u>H. M. Billingsley</u>	Description & Color of Materials Sand, Clay, Red Clay, Shell, etc.	Thick- ness Feet	Depth Feet
(Name)	0-15 Surface clay	15	
<u>Nesbit, Miss.</u>	15-85 Tough gravel	70	
(Address)	85-125 Fine sand, clay striks	40	
(2) Location: <u>1/4, 1/4, Sec. 14 T. 2 R. 8</u>	125-164 Fine sand	39	
<u>2</u> miles <u>N.W.</u> , of <u>Nesbit</u>	164-175 Med. coarse, some coarse	11	
(distance) (direction) (Nearest Town)			
(3) Topography: <u>Hilly</u>			
(Hilly) (Flat) (Level)			
(4) Purpose of Well: <u>Domestic</u>			
(Domestic Irrigation Municipal, Industrial, Other)			

CODED

Information upon completion of well:

(1) Diameter 2 1/2 inches.

(2) Total Depth 175 feet.

(3) Water Level 108 feet below top of ground.

(4) Cased to None, Size None


(5) Screen: Size 1 1/8", Length 8 ft

(6) Were any formations sealed against pollution?
 yes, No no.

If YES depth of formation _____

Why _____

Drillers Remarks: _____

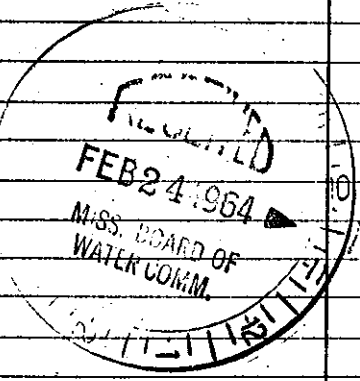

Well No.

(Use Back Side)

Mail this copy to Board of Water Commissioners 429 Miss. St. Jackson, Miss