

DESOTO MISSISSIPPI BOARD OF WATER COMMISSIONERS

F 62

11-25-63

WATER WELL DRILLERS LOG

CODED

Date: Nov. 25, 19 63, Driller: Deep South Well Co. County Desoto
(Name)

	Description & Color of Materials Sand, Clay, Red Clay, Shell, etc.	Thick- ness Feet	Depth Feet
(1) Owner of Land: <u>Banks & Company</u> <small>(Name)</small>	0-31 Surface clay	31	
<u>Hernando, Miss.</u> <small>(Address)</small>	31-45 Red sand, some gravel	14	
(2) Location: <u>1/4, 1/4, Sec. 35 T2R8,</u>	45-62 Tough gravel	17	
<u>4 miles N.W., of Hernando,</u> <small>(distance) (direction) (Nearest Town)</small>	62-119 Yellow sandy clay	57	
(3) Topography: <u>Hilly</u> <small>(Hilly) (Flat) (Level)</small>	119-134 Fine sand, clay	15	
(4) Purpose of Well: <u>Domestic</u> <small>(Domestic Irrigation Municipal, Industrial, Other)</small>	134-183 White clay, sand	49	
	183-188 Hard fine sand	5	
	188-194 Med. coarse sand	6	
	194-205 Coarse & med. coarse sand	11	

Information upon completion of well:


- (1) Diameter 2 1/8 inches.
- (2) Total Depth 205 feet.
- (3) Water Level 111 feet below top of ground.
- (4) Cased to _____, Size _____
- (5) Screen: Size 1 1/8", Length 8 ft
- (6) Were any formations sealed against pollution?
 yes, no.

If YES depth of formation _____

Why _____

Drillers Remarks: _____

CODED

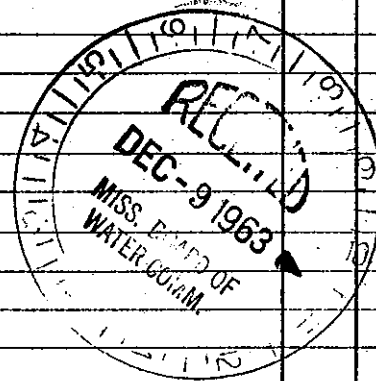

Well No.

(Use Back Side)

Mail this copy to Board of Water Commissioners 429 Miss. St. Jackson, Mis.