

De Soto
 F 88
 2-27-75

MISSISSIPPI
 BOARD OF WATER COMMISSIONERS
 416 North State Street
 Jackson, Mississippi 39201
 CODED

WATER WELL DRILLERS LOG

2-27-1975 date well completed
 W.R. Mason Water Well Driller firm name
 De Soto county well located

LANDOWNER: J.J. Sides
 R.F. 1, Nesbitt Miss.
 (mailing address)
 WELL LOCATION:
 sec. 14 T. 2 N. R. 8 E. 155
 2 miles N of Nesbitt
 (distance) (direction) (nearest town)


description of formations encountered	from	to
Clay Lint	10	10
Red clay	10	27
gravel	27	50
Blue clay	50	145
white sand	145	198

WELL PURPOSE: Home
 (home, irrigation, municipal, industrial)

WELL COMPLETION DATA:
 (1) diameter (inches) 4"
 (2) total depth (feet) 196'
 (3) static water level (feet) 145' below top of ground.
 (4) casing Plastic 176'
 (material) (depth)
 4" (size) if telescope see back.
 (5) screen 20' 176'
 (length) (depth to top)
 4" Plastic
 (size) (material)
 (6) pump 3/4 5
 (HP) (yield gpm)
 electric
 (type power)
 (7) electric log No
 (yes or no)

(organization running log)
 (8) how well bottom plugged
 Cap on screen

DRILLERS REMARKS:

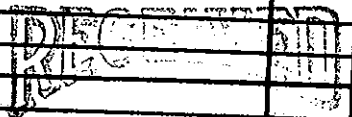

JUL 01 1975