

Well
As b.

Page

MON 02:18 ID: [redacted]

DeSoto Co.

TEL NO:

#019 P0

DRAWING OF THE WELL

Municipal - Industrial Wells
 Pumping Equipment
 Complete Repair Service
 Chemical Treating



NEW CASTLE
 RT. 2, WHITEVILLE, TENN. 38075

Ph. 901-254-8010

WELL CONSTRUCTION DATA

CONTRACT NO. _____

OUR WELL NO. 1 THEIR WELL NO. 3 INTEREST HOLE NO. _____

LOCATION OF THE WELL Horn Lake Water Assn Plant - Court Rd INSTALLED FOR _____

ADDRESS CITY Horn Lake COUNTY DeSoto STATE Miss

STARTED WELL _____ AND COMPLETED _____
 TOTAL DEPTH 472'-6" ELEVATION 26.1956 STATIC WATER LEVEL 130'
 LENGTH SURFACE CASING _____ SIZE _____ THICKNESS _____

CEMENTED WITH _____ SACKS CEMENT _____ TYPE PACKER _____
 LENGTH WELL CASING 412' SIZE 12" WEIGHT _____
 CEMENTED WITH _____ SACKS CEMENT _____ TYPE PACKER _____

INNER CASING LENGTH 366' SIZE _____ WEIGHT _____
 WITH 4" x 2" SACKS CEMENT _____ TYPE PACKER _____
 LEAD SEAL _____ GUIDES LOCATED 405' & 366' TYPE SACKOFF _____

WELL _____ BACKPRESSURE VALVE Yes GUIDE _____
 TYPE _____ SIZE 2" LENGTH 60' OPENING 24"
 SIZE HOLE DRILLED FOR SURFACE CASING _____ WITH _____ CONNECTIONS _____

SIZE HOLE DRILLED FOR WELL CASING _____ WITH _____
 YARDS OF GRAVEL USED _____ WITH Baller Hole Screen
 HOW WAS WELL DEVELOPED Blow HOW PLACED Under Pressure


NOTES: _____
 RIG USED Cyclone Mud Rotary Driller DRILLER Sam Smith - Tubular

PURPOSE FOR WHICH THIS WATER IS USED _____ GENERAL _____
 TEMPERATURE _____ IS WATER CLEAN Water N.T.
 SAND _____ HARDNESS _____ CAPACITY _____

TYPE TREATMENT USED _____ PH _____ IRON _____ N & CL _____
 IS THERE A DERRICK OVER THE WELL _____ HEIGHT _____ TYPE _____

CAP _____ PUMP HOUSE _____ SIZE MATCH _____

REMARKS _____

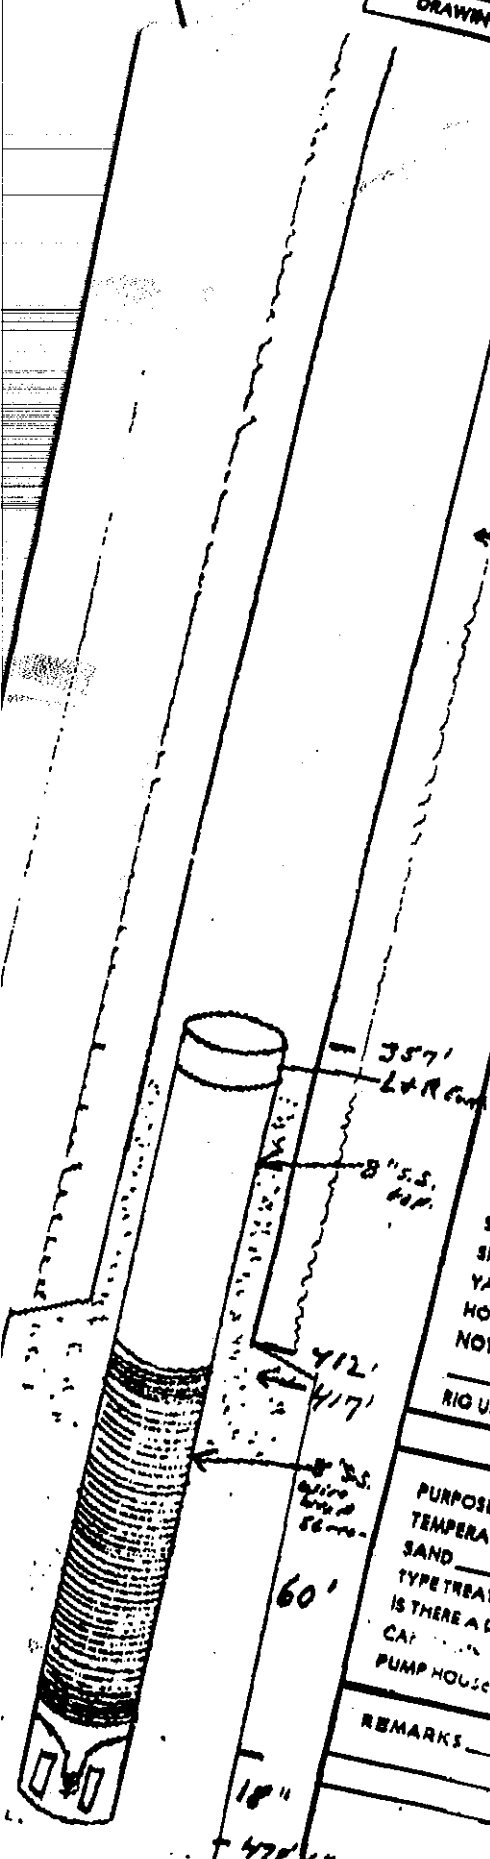

Des

F

SEC 2 T 2 R 8

60'

18"

472'-6"