State W	ell Report				
1 / 1 4	Oriller's Log	For Office Use Only:			
Mississippi Departmen	it of Environmental Quality	Aquifer:			
Permit #: Office of Land a	Office of Land and Water Resources				
Duller: 10067 COV 14 6:201	P.O. Box 10631				
1 20 -1	IS 39289-0631 961-5210	L. S. Elevation:			
	4-6938 (fax)	E-log #:			
State Law requires that this report be prepared by the license holder responsible for the work and filed with the Department at the above address within 30 days of completion of drilling of the well or borehole.					
Information on Well Owner	1 Paris and the second	rehole Location			
(Landowner if borehole is not for a water well)	Toring 34 . 53 . 714	" I amainta 0900 02, 686			
Owner Name Ben Smith	<u> </u>	" Longitude: <u>270。23</u> , 6 8 6, 4 //			
Mailing Address: 3305 Nikki Ridge Dr&	Method of Lat/Long (circle one	e): Conventional Survey,			
	USGS quad, Hand-held				
Neshit MS 38651	5E 4NE 4 Sec 31	$_{\text{Twn}} \frac{25}{25} R_{\text{Rng}} \frac{8\omega}{2}$			
Neshit MS 38651 City 62 State Zip Code	Distance Direction Miles NE o	Nearest Town			
Telephone No. 393-0714	Miles NE o	of UEOLOS COLHE			
Well / Bore	hala Data				
		63).			
Date drilling started: 6-38-6 Date drilling completed: 6-38-6	Hole depth: 245	Hole diameter: 6 3/4			
Location of the source of any surface water used for drilling: 100 Method of dosing and volume of Chlorine used in drilling and devel	opment: ,JW				
Logs run (circle all applicable): No log run Electric Gamma Ray Name of organization running log(s): r-A	Density Sonic Neutron C	Other:			
Purpose of borehole (check one): Water Well Ceotechnical/Geole	ogical Investigation Ground	Source Heat Pump			
Seismic Survey Other (describe					
If drilling is not related to water well construction					
Purpose of Well (check one): Home Industrial Public Supply Irrigation Fish Culture Other:					
If a flowing well, method of flow regulation: ValveO					
Static Water Level:feet above or below circle one) land surface Date measured:					
Method of Measurement (circle one) steel tape electric tape air line other: String loois with					
Well depth: 345 Well grouted to a depth of 50 feet Type of grout (circle one): Neat Cement Bentonite Mix					
Casing length: 325 feet Casing diameter: inches Type of casing:					
Screen length:feet	Screen length:				
Screen slot size: Olo inches Setting depth: From 335 feet to 345 feet					
Type of completion (circle all applicable): Gravel packed Underreamed Telescoped Open hole Natural Development					
Other (describe): N					
Top of lap pipe or reduction in casing: feet. If telescoped or more than one screen, describe on next page					
Form: OLWR-SWR-1A					

RECEIVED

JUL 27 2006

BY: OLWR


The sketch	below o	only reaui	red for v	vater wells

ľ	well	teles	copes	show	depths	on	sketch
_	Gre	haus	Laval				

Description of formations encountered must be provided for all wells and boreholes, unless specifically exempted by regulations

Description of Formations Encountered	From (depth)	To (depth)
Clay dirt	Ground Level	32
white clay	35-	95-
five sand.	62	150
white Soud	150	345

If more than one screen, show location of each on sketch

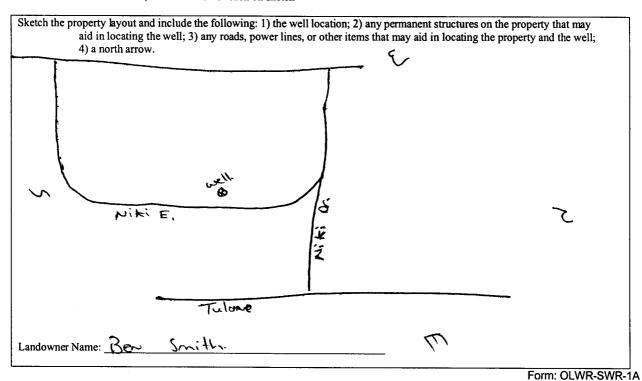

I certify that the well/borehole was drilled, constructed, and completed in accordance with all applicable requirements of the Mississippi Department of Environmental Quality and the Mississippi Department of Health regulations, if applicable, and state

Print Name of Responsible Licensee and License No.			Date	
Jones	w. Mason	0-626	7-27-06	
laws.				

RECEIVED

JUL 27 2006

BY: OLWR

STATE WELL REPORT Part 2 County: Desate For Office Use Only: **Pump Installer's Completion Report** Permit #: Mississippi Department of Environmental Quality Aquifer: Office of Land and Water Resources Driller: Jones W. Macon. P.O. Box 10631 Date completed: 6 - 2806 Jackson, MS 39289-0631 Well #: (601)961-5210 Elevation: (601)354-6938 (fax) Copy information from block on Part 1 This part of the report must be completed by a licensed water well contractor or a licensed pump installer. A copy of Part 1 of the report must be attached and both parts filed with the Department at the above address within 30 days of well completion. Well Owner Information Well Location Latitude: 37 53 714 Longitude: 70 - 62 - 686 43 Method of Lat/Long (check one): Conventional Survey_____, Smith USGS quad , Hand-held GPS , Survey-grade GPS Nesbit City SE "NE" Sec 21 T25 R Distance Direction Telephone No. (662) 393 0714 11/2 Miles NE of Dows corner **Pump Type Power Type** Circle one Circle one Air Lift Jet Submersible Diesel Engine Gasoline Engine Natural Gas Bucket Piston Turbine Electric Motor Hand Tractor PTO Centrifugal Rotary Flowing Well Windmill Other (specify): Horse Power Rating of Motor: 5 100 Other (specify): 6-28-06 180 feet Date Pump Installed: Setting Depth: 60 Gallons Per Minute Rated Pump Capacity: Number of Stages: **Pump Test Data** Method of Measuring Water Level Circle one 6-21-06 Date Well Tested: Air Line Electric Measuring Line Steel Tape 90 Feet Below Land Surface Other (specify): String (weight Pumping Water Level (B): ~ 4 Feet Below Land Surface ジA Feet Below Land Surface Drawdown [(B) - (A)]: ____ For flowing well, measured shut in head: _ MA Test Pumping Rate: Gallons Per Minute Well yielded GPM with a drawdown of Duration of Pump Test (minimum 4 hours): hours hours of pumping I HEREBY CERTIFY that the above statements are true to the best of my knowledge.

lones in Noson

Print Name of Pump Installer and License No. (if applicable)

Form: OLVER ENCE VED

Signature of Pump Installer

JUL 27 2006

BY: OLWR