

Desoto to locate

WATER WELL DRILLERS LOG

F?

Date: 6-10-61, 1961, Driller: C. B. Perry County Desoto

(1) Owner of Land:	Description & Color of Materials Sand, Clay, Red Clay, Shell, etc.	Thick- ness Feet	Depth Feet
Jack Perry <small>(Name)</small> Church Rd <small>(Address)</small>	0-26 Clay		
(2) Location: 1/4, 1/4, Sec. 24 T2R8,	26-32 gravel		
2 1/2 miles S.W. of Hamlet <small>(distance) (direction) (Nearest Town)</small>	32-82 white clay		
(3) Topography: hilly	82-105 blue shale		
<small>(Hilly) (Flat) (Level)</small>	105-120 fine sand		
(4) Purpose of Well: Domestic	120-157 gravel		
<small>(Domestic Irrigation Municipal, Industrial, Other)</small>	157-157 4" rock		
	157-4"-194 bumbo		
	194-199 fine sand		
	199-218 fine sand		
	218-330 med sand		
	230-239 coarse sand		


Information upon completion of well:

- (1) Diameter 2 inches.
- (2) Total Depth 239 feet.
- (3) Water Level 96 feet below top of ground.
- (4) Cased to 234, Size 2
- (5) Screen: Size 1/4", Length 6ft
- (6) Were any formations sealed against pollution?
 yes, no.

If YES depth of formation _____

Why General Practice

Drillers Remarks: annular space between casing & hole
puddled in

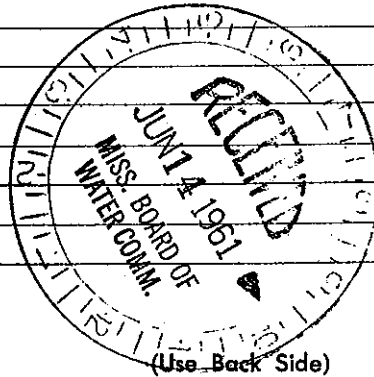

Well No.