

Desoto

F  
7-61 2001

### WATER WELL DRILLERS LOG

Date: July 19 61, Driller: P.C. Henderson County Desoto  
Name

(1) Owner of Land: <u>J. J. Allen</u> <small>(Name)</small>	Description & Color of Materials Sand, Clay, Red Clay, Shell, etc.	Thick- ness Feet	Depth Feet
<u>Thomas Lake</u> <small>(Address)</small>	40' Red Clay	40	
(2) Location: <u>1/4, 1/4, Sec. 28</u>	7' White Clay	10	
<u>10</u> miles <u>North</u> , of <u>Th</u> <small>(distance) (direction) (Nearest Town)</small>	White Sand	17	
(3) Topography: <u>Level</u> <small>(Hilly) (Flat) (Level)</small>			69
(4) Purpose of Well: <small>(Domestic Irrigation Municipal, Industrial, Other)</small>			

#### Information upon completion of well:


0052

- (1) Diameter 2 1/2 inches.
- (2) Total Depth 69 feet.
- (3) Water Level 50 feet below top of ground.
- (4) Cased to 63, Size 2 1/2.
- (5) Screen: Size 1 1/2, Length 1'.
- (6) Were any formations sealed against pollution?  
\_\_\_\_\_ yes, \_\_\_\_\_ no.

If YES depth of formation \_\_\_\_\_

Why \_\_\_\_\_

Drillers Remarks: \_\_\_\_\_

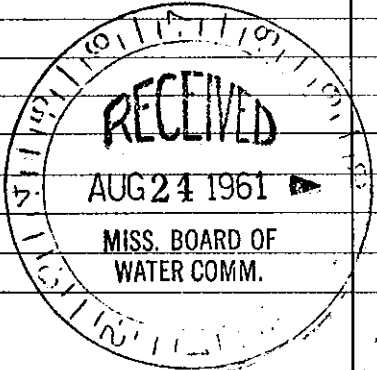

(Use Back Side)

Well No.

Retain this copy for your office files.