

Desoto

F 2002

Date: 8-1-62, 1962, Driller: H+H Well Co. County Desoto  
8-1-62 A.C. HENDERSON

(1) Owner of Land: W.M. Cook  
(Name)  
R.F.P. Hernandez  
(Address)

(2) Location: 8 NW. Hernandez  
miles (distance) 8 NW. Hernandez (direction), of Hernandez (Nearest Town)

(3) Topography: X  
(Hilly) (Flat) (Level)

(4) Purpose of Well: Home  
(Domestic Irrigation  
Municipal, Industrial, Other)

Description & Color of Materials Sand, Clay, Red Clay, Shell, etc.	Thick- ness Feet	Depth Feet
<u>Red clay</u>	<u>65</u>	<u>147</u>
<u>Sand (dry)</u>	<u>30</u>	
<u>white clay</u>	<u>20</u>	
<u>white sand</u>	<u>32</u>	

Information upon completion of well:

- (1) Diameter 2 inches.
- (2) Total Depth 147 feet.
- (3) Water Level 105 feet below top of ground.
- (4) Cased to 141, Size 2.
- (5) Screen: Size 1 1/4, Length 6'.
- (6) Were any formations sealed against pollution?  
\_\_\_\_\_ yes, \_\_\_\_\_ no.


If YES depth of formation \_\_\_\_\_

Why \_\_\_\_\_

Drillers Remarks: \_\_\_\_\_

Retain this copy for your office files.

Rod Pump

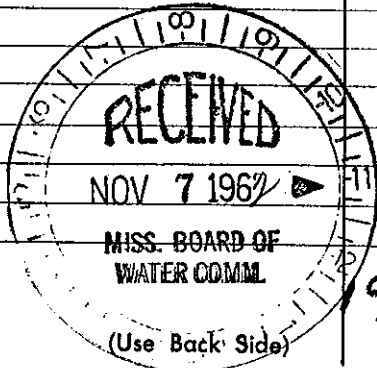

19

Well No.