


Desoto MISSISSIPPI BOARD OF WATER COMMISSIONERS

~~2~~ F 2007 WATER WELL DRILLERS LOG
10-12-62

Date: Oct. 12, 19 62, Driller: Deep South Well Co. County DeSoto

(Name)

	Description & Color of Materials Sand, Clay, Red Clay, Shell, etc.	Thick- ness Feet	Depth Feet
(1) Owner of Land: <u>Abner Lauderdale</u> (Name) <u>Hernando, Miss.</u> (Address)	0-25 Surface clay	25	
(2) Location: <u>1/4, 1/4, Sec. 18 T2 R3</u> , <u>2 1/2</u> miles <u>S.E.</u> , of <u>Horn Lake</u> (distance) (direction) (Nearest Town)	25-40 Red sand, some	15	
(3) Topography: <u>Hilly</u> (Hilly) (Flat) (Level)	40-80 Yellow gravel	40	
(4) Purpose of Well: <u>Domestic</u> (Domestic Irrigation Municipal, Industrial, Other)	80-120 Blue clay	40	
Information upon completion of well:	120-148 Blue clay, sand	28	
(1) Diameter <u>3</u> inches.	148-177 Med. sand strks	29	
(2) Total Depth <u>196</u> feet.	177-182 Med. coarse, clay	5	
(3) Water Level <u>90</u> feet below top of ground.	182-196 Coarse & med. coarse	14	
(4) Cased to <u>None</u> , Size <u>None</u> .			
(5) Screen: Size <u>2"</u> , Length <u>8 ft</u> .			
(6) Were any formations sealed against pollution? <u>no</u> yes, <u>no</u> no.			
If YES depth of formation _____			
Why _____			
Drillers Remarks: _____			

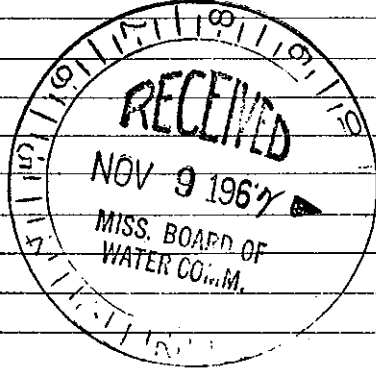

(Use Back Side)

Well No.

Mail this copy to Board of Water Commissioners 429 Miss. St. Jackson, Mis