

De Soto
G-19
9-65

MISSISSIPPI BOARD OF WATER COMMISSIONERS

WATER WELL DRILLERS LOG **CODED**

Date: 9-2-, 1965, Driller: Layne-Central Co., County DeSoto
(Name)

(1) Owner of Land: <u>Pleasant Hill Water Assn.</u> (Name)	Description & Color of Materials Sand, Clay, Red Clay, Shell, etc.	Thick- ness Feet	Depth Feet
<u>Pleasant Hill, Mississippi</u> (Address)	Top soil	1	0 1
(2) Location: <u>1/4, NE 1/4, Sec. 2 T2R7</u> <u>S W</u> _____ miles _____ of _____ (distance) (direction) (Nearest Town)	sandy clay	25	26
	sand-gravel	50	76
	clay	12	88
	sand stks clay	55	143
	clay	93	236
(3) Topography: _____ (Hilly) (Flat) (Level)	sand stks clay	10	246
(4) Purpose of Well: <u>Municipal</u> (Domestic Irrigation Municipal, Industrial, Other)	h.p. sand	28	274
	clay	5	279

Information upon completion of well:


- (1) Diameter 10 inches.
- (2) Total Depth 279' 1" feet.
- (3) Water Level 120 feet below top of ground.
- (4) Cased to 220' 8", Size 8"
- (5) Screen: Size 6", Length 35' 7"
- (6) Were any formations sealed against pollution?
x yes, _____ no.

If YES depth of formation 220' 8"

Why required

Drillers Remarks: _____

CODED

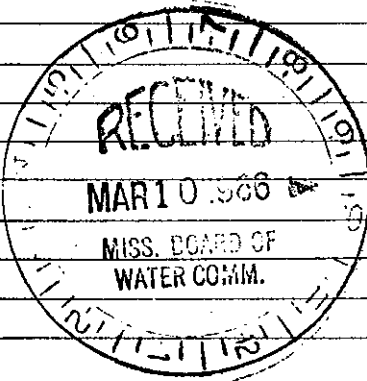

Well No.

(Use Back Side)