

DeSoto MISSISSIPPI BOARD OF WATER COMMISSIONERS

**WG35**

10-31-62


WATER WELL DRILLERS LOG

**CODED**

Date: Oct. 31, 19 62, Driller: Deep South Well Co. County DeSoto  
(Name)

(1) Owner of Land: <u>Arthur Wallace</u> (Name)	Description & Color of Materials Sand, Clay, Red Clay, Shell, etc.	Thick- ness Feet	Depth Feet
<u>Route 1, Nesbit, Miss.</u> (Address)	0-35 Surface clay	35	
(2) Location: <u>1/4, 1/4, Sec. 7 T2R7,</u>	35-45 Sand & Gravel	10	
<u>2 1/2</u> miles <u>N.E.</u> , of <u>Nesbit</u> (distance) (direction) (Nearest Town)	45-80 Red sand, clay	35	
(3) Topography: <u>Hilly</u> (Hilly) (Flat) (Level)	80-135 White clay strks	55	
(4) Purpose of Well: <u>Domestic</u> (Domestic Irrigation Municipal, Industrial, Other)	135-164 Sandy white clay	29	
Information upon completion of well:	164-174 Med. fine sand,	10	
(1) Diameter <u>3</u> inches.	174-182 ditto clay strks	8	
(2) Total Depth <u>207</u> feet.	182-188 Med. coarse sand and med. fine	6	
(3) Water Level <u>130</u> feet below top of ground.	188-192 Med. coarse, clay strks	4	
(4) Cased to <u>None</u> , Size <u>None</u> .	192-203 Med. coarse & some coarse (soft)	11	
(5) Screen: Size <u>2</u> , Length <u>8 ft</u> .	203-207 Med. coarse sand (hard)	4	
(6) Were any formations sealed against pollution? <u>no</u> yes, <u>no</u> no.			
If YES depth of formation _____			
Why _____			
Drillers Remarks: _____			
_____			
_____			
**CODED**

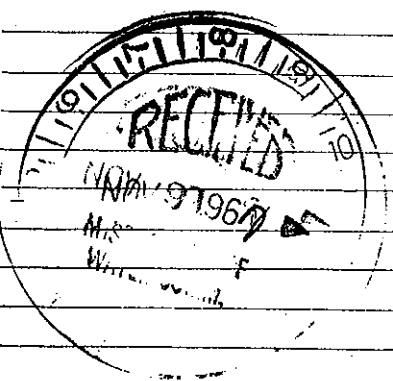

Well No.

(Use Back Side)

Mail this copy to Board of Water Commissioners 429 Miss. St. Jackson, Mis