

MISSISSIPPI BOARD OF WATER COMMISSIONERS

Desoto
WG37
3-2-61


WATER WELL DRILLERS LOG

CODED

Date: March 2, 1961, Driller: Deep South Well Co. County Desoto
(Name)

(1) Owner of Land: <u>Sell Newsom</u> (Name)	Description & Color of Materials Sand, Clay, Red Clay, Shell, etc.	Thick- ness Feet	Depth Feet
<u>Box 16, Nesbit, Miss.</u> (Address)	<u>0-25 Surface clay</u>	<u>25</u>	
(2) Location: <u>2</u> $\frac{1}{4}$, <u>19</u> $\frac{1}{4}$, Sec. <u>19 T 2 R 7</u>	<u>25-75 Red sand & clay</u>	<u>50</u>	
<u>2</u> miles <u>N.E.</u> , of <u>Nesbit, Miss.</u> (distance) (direction) (Nearest Town)	<u>75-104 Sandy blue clay</u>	<u>29</u>	
(3) Topography: <u>Hilly</u> (Hilly) (Flat) (Level)	<u>104-200 Hard blue clay</u>	<u>96</u>	
(4) Purpose of Well: <u>Domestic</u> (Domestic Irrigation Municipal, Industrial, Other)	<u>200-258 Fine sand, clay</u>	<u>58</u>	
Information upon completion of well:	<u>258-274 White clay, sand</u>	<u>16</u>	
(1) Diameter <u>2$\frac{1}{8}$</u> inches.	<u>274-287 Stks med sand</u>	<u>13</u>	
(2) Total Depth <u>332</u> feet.	<u>287-288 Hard rock</u>	<u>1</u>	
(3) Water Level <u>112</u> feet below top of ground.	<u>288-305 Blue clay</u>	<u>17</u>	
(4) Cased to <u>None</u> , Size _____	<u>305-325 Med sand</u>	<u>20</u>	
(5) Screen: Size <u>1$\frac{1}{2}$"</u> , Length <u>8 ft</u>	<u>325-332 Coarse & med.</u>	<u>7</u>	
(6) Were any formations sealed against pollution? _____ yes, <u>No</u> no.	<u>coarse sand</u>		
If YES depth of formation _____			
Why _____			
Drillers Remarks: _____			

CODED

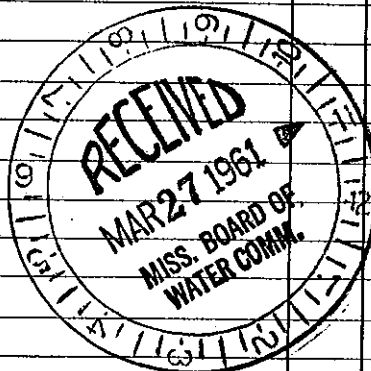

Well No.

(Use Back Side)

This copy to Board of Water Commissioners 429 Miss. St. Jackson, Miss