

DeSoto MISSISSIPPI BOARD OF WATER COMMISSIONERS


FG38
6-2-62

WATER WELL DRILLERS LOG

13
CODED

Date: June 2, 1962, Driller: Deep South Well Co. County DeSoto
(Name)

(1) Owner of Land: <u>John Saulsberry</u> (Name)	Description & Color of Materials Sand, Clay, Red Clay, Shell, etc.	Thick- ness Feet	Depth Feet
<u>Route #1, Horn Lake, Miss.</u> (Address)	<u>0-30 Surface clay</u>	<u>30</u>	
(2) Location: <u>1/4, 1/4, Sec. 5 T2R7</u>	<u>30-32 Sand & Gravel</u>	<u>2</u>	
<u>3 1/2</u> miles <u>S.W.</u> of <u>Horn Lake</u> (distance) (direction) (Nearest Town)	<u>32-97 Red purplish clay</u>	<u>65</u>	
(3) Topography: <u>Hilly</u> (Hilly) (Flat) (Level)	<u>97-99 Fine sand</u>	<u>2</u>	
(4) Purpose of Well: <u>Domestic</u> (Domestic Irrigation Municipal, Industrial, Other)	<u>99-197 Blue clay</u>	<u>98</u>	
Information upon completion of well:	<u>197-210 Yellow sandy clay</u>	<u>13</u>	
(1) Diameter <u>2 1/2</u> inches.	<u>210-228 Fine sand, clay</u>	<u>18</u>	
(2) Total Depth <u>282</u> feet.	<u>228-244 White sandy clay</u>	<u>16</u>	
(3) Water Level <u>141</u> feet below top of ground.	<u>244-250 Med. fine sand</u>	<u>6</u>	
(4) Cased to <u>None</u> , Size <u>None</u> .	<u>250-267 Fine sand</u>	<u>17</u>	
(5) Screen: Size <u>1 1/2"</u> , Length <u>8 ft</u> .	<u>267-273 Med. sand</u>	<u>6</u>	
(6) Were any formations sealed against pollution? <u>no</u> yes, <u>X</u> no.	<u>273-282 Coarse sand</u>	<u>9</u>	
If YES depth of formation _____	CODED		
Why _____			
Drillers Remarks: _____			

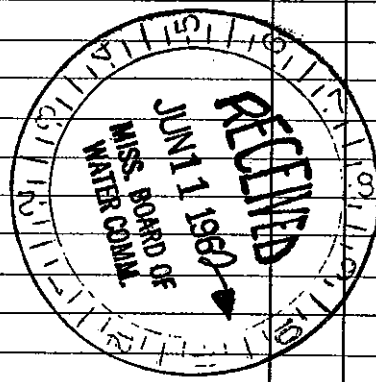

Well No.

(Use Back Side)

Mail this copy to Board of Water Commissioners 429 Miss. St. Jackson, Miss.