

G39

7-12-62


WATER WELL DRILLERS LOG

**CODED**

Date: July 12, 1962, Driller: Deep South Well Co., County: Desoto  
(Name)

1) Owner of Land: <u>Mr. George Moore</u> (Name)	Description & Color of Materials Sand, Clay, Red Clay, Shell, etc.	Thick- ness Feet	Depth Feet
<u>Nesbit, Miss.</u> (Address)	0-15 Surface clay	15	
(2) Location: <u>1/4, 1/4, Sec. 2227 T 2 R 1</u>	15-45 White clay	30	
<u>3</u> miles <u>West</u> , of <u>Pleasant Hill</u> (distance) (direction) (Nearest Town)	45-50 Tough gravel	5	
(3) Topography: <u>Hilly</u> (Hilly) (Flat) (Level)	50-52 Hard rock	2	
(4) Purpose of Well: <u>Domestic</u> (Domestic Irrigation Municipal, Industrial, Other)	52-85 Fine sand, clay	33	
Information upon completion of well:	85-87 Hard rock strks	2	
(1) Diameter <u>3</u> inches.	87-100 Lignite	13	
(2) Total Depth <u>210</u> feet.	100-178 Blue clay	78	
(3) Water Level <u>148</u> feet below top of ground.	178-193 Fine sand	15	
(4) Cased to <u>None</u> , Size <u>None</u> .	193-210 Med.coarse, some coarse	17	
(5) Screen: Size <u>2"</u> , Length <u>8 ft</u> .			
(6) Were any formations sealed against pollution? <u>no</u> yes, <u>No</u> no.			
If YES depth of formation _____			
Why _____			
Drillers Remarks: _____			
_____			
_____			

**CODED**

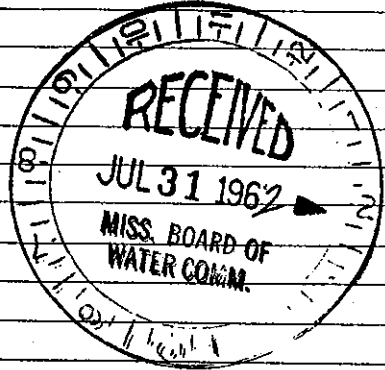

Well No.

(Use Back Side)