

DESOTO MISSISSIPPI BOARD OF WATER COMMISSIONERS

DG43

7-10-65 WATER WELL DRILLERS LOG

CODED :

Date: 7-10, 1965, Driller: Harris Bros. County Auto
Beuld (Name Harris)

(1) Owner of Land: <u>Douglas Rayburn</u> (Name)	Description & Color of Materials Sand, Clay, Red Clay, Shell, etc.	Thick- ness Feet	Depth Feet
<u>Nesbit</u> (Address)	<u>top soil</u>	<u>0</u>	<u>25</u>
(2) Location: <u>1/4, 1/4, Sec. 30 T. 2R. 7.</u>	<u>sand and gravel</u>	<u>25</u>	<u>40</u>
_____ miles _____ of _____ (distance) (direction) (Nearest Town)	<u>grey clay</u>	<u>40</u>	<u>140</u>
(3) Topography: _____ (Hilly) (Flat) (Level)	<u>clay and cemented sand</u>	<u>140</u>	<u>170</u>
(4) Purpose of Well: _____ (Domestic Irrigation Municipal, Industrial, Other)	<u>white sand</u>	<u>170</u>	<u>194</u>

CODED

Information upon completion of well:

(1) Diameter 4 inches.

(2) Total Depth 194 feet.

(3) Water Level 100 feet below top of ground.

(4) Cased to 180, Size 4"


(5) Screen: Size 4", Length 14'

(6) Were any formations sealed against pollution?
 _____ yes, _____ no.

If YES depth of formation _____

Why _____

Drillers Remarks: _____

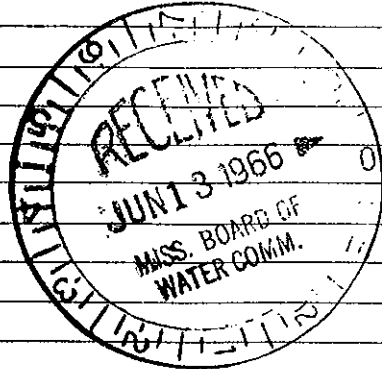

Well No.

(Use Back Side)

Mail this copy to Board of Water Commissioners 429 Miss. St. Jackson, Miss.