

Desoto

MISSISSIPPI BOARD OF WATER COMMISSIONERS

8-65

WATER WELL DRILLERS LOG CODED

Date: 8-19-65 Driller: Harris Bros. County: Desoto

(1) Owner of Land: Otis W. Flynn Nestletts, Miss

Table with 4 columns: Description & Color of Materials, Thickness Feet, Depth Feet. Rows include top soil, sand + pea gravel, gray clay + fine sand, fine cemented clay, coarse white sand.

(2) Location: 1/4, 1/4, Sec. 19 T. 2 R. 7


(3) Topography: (Hilly) (Flat) (Level)

(4) Purpose of Well: (Domestic Irrigation, Municipal, Industrial, Other)

Information upon completion of well:

- (1) Diameter: 4 inches.
(2) Total Depth: 345 feet.
(3) Water Level: 145 feet below top of ground.
(4) Cased to: 324', Size: 4"
(5) Screen: Size: 4", Length: 7'
(6) Were any formations sealed against pollution? yes, no.

CODED

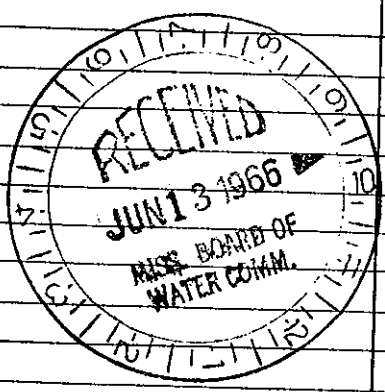

If YES depth of formation: Why: Drillers Remarks: Yield in gpm: 45 Size pump: 3 H.P. Type power: electric

Mail this copy to Board of Water Commissioners 429 Miss. St. Jackson, Miss.