

DeSoto  
 249  
 2-68

**CODED**

MISSISSIPPI  
 BOARD OF WATER COMMISSIONERS  
 416 North State Street  
 Jackson, Mississippi 39201

WATER WELL DRILLERS LOG

7/18 1968 Bob Smith DeSoto  
 date well completed firm name county well located

LANDOWNER: Wright  
 Neshit, Miss  
 (mailing address)

description of formations encountered	from	to
top soil	0	10
red clay	10	40
red gravel	40	60
white clay	60	100
white sand	100	125


WELL LOCATION:  
 sec. 18 T. 2 R. 7 E  
 3 miles north of Neshit  
 (distance) (direction) (nearest town)

WELL PURPOSE: Home  
 (home, irrigation, municipal, industrial)

**CODED**

WELL COMPLETION DATA:

- (1) diameter (inches) 4
- (2) total depth (feet) 125
- (3) static water level (feet) 145 below top of ground
- (4) casing plastic 125  
 (material) (depth)
- (5) screen 20 155  
 (length) (depth to top)
- (6) pump 1/2 10  
 (HP) (yield gpm)
- Electric  
 (type power)
- (7) electric log NO  
 (yes or no)
- (organization running log)
- (8) how well bottom plugged plugged

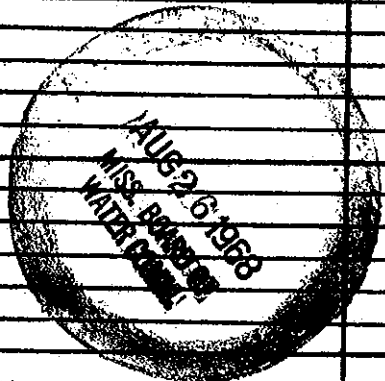

DRILLERS REMARKS:  
 good drilling