

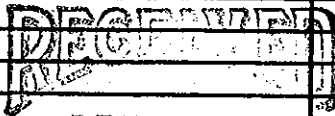
De Soto
G 64
2-6-74

MISSISSIPPI
BOARD OF WATER COMMISSIONERS
416 North State Street
Jackson, Mississippi 39201

CODED

WATER WELL DRILLERS LOG

2-6-1974 W.R. Mason De Soto
date well completed firm name county well located

LANDOWNER:	description of formations encountered	from	to
Jessie King RFD, Olive Branch Miss (mailing address)			
WELL LOCATION:	gravel coarse sand	15	70
sec. 15 T 2 N R 7 E 1 1/2 miles West of Pleasant Hill (distance) (direction) (nearest town)	Blue clay	at	70
WELL PURPOSE: Home (home, irrigation, municipal, industrial)	CODED		
WELL COMPLETION DATA:			
(1) diameter (inches) 4			
(2) total depth (feet) 70'			
(3) static water level (feet) 60' below top of ground.			
(4) casing Plastic 60' (material) (depth)			
4" (size) if telescope see back.			
(5) screen 10' 60' (length) (depth to top)			
4" (size) Plastic (material)			
(6) pump 1/3 5 (HP) (yield gpm)			
electric (type power)			
(7) electric log No. (yes or no)			
(organization running log)			
(8) how well bottom plugged caps			
DRILLERS REMARKS:			
 DEC 27 1974 MISS. BD. OF WATER COMM			