

County: Desoto  
 Permit #: \_\_\_\_\_  
 Driller: Jones w. Moser  
 Date drilling completed: 8-24-05

### State Well Report Part 1 – Driller's Log

Mississippi Department of Environmental Quality  
 Office of Land and Water Resources  
 P.O. Box 10631  
 Jackson, MS 39289-0631  
 (601)961-5210  
 (601)354-6938 (fax)

**For Office Use Only:**  
 Aquifer: \_\_\_\_\_  
 Well #: G-93  
 L. S. Elevation: \_\_\_\_\_  
 E-log #: \_\_\_\_\_

*State Law requires that this report be prepared by the license holder responsible for the work and filed with the Department at the above address within 30 days of completion of drilling of the well or borehole.*

Information on Well Owner (Landowner if borehole is not for a water well)	Well or Borehole Location
Owner Name: <u>Brain Hill</u>	Latitude: <u>34° 54' 674"</u> Longitude: <u>89° 56' 234"</u>
Mailing Address: <u>Cherry Tree Park</u>	Method of Lat/Long (circle one): Conventional Survey, <u>41</u>
<u>Subdivision entrance</u> <u>Getwell rd south of church rd.</u>	USGS quad, <u>Hand-held GPS</u> , Survey-grade GPS
<u>Southaven MS. 38672</u>	<u>SE</u> ¼ <u>NE</u> ¼ Sec <u>9</u> Twn <u>25</u> Rng <u>7W</u>
City: _____ State: _____ Zip Code: _____	Distance: <u>3 1/2</u> Miles Direction: <u>SE</u> of <u>plum Point</u>
Telephone No. <u>(662) 429-7776</u>	

**Well / Borehole Data**

Date drilling started: 8-24-05 Date drilling completed: 8-24-05 Hole depth: 240' Hole diameter: 8"

Location of the source of any surface water used for drilling: NA

Method of dosing and volume of Chlorine used in drilling and development: NA

Logs run (circle all applicable): No log run Electric Gamma Ray Density Sonic Neutron Other: \_\_\_\_\_

Name of organization running log(s): NA

Purpose of borehole (check one): Water Well  Geotechnical/Geological Investigation \_\_\_\_\_ Ground Source Heat Pump \_\_\_\_\_

Seismic Survey \_\_\_\_\_ Other (describe) \_\_\_\_\_

***If drilling is not related to water well construction, skip the remainder of this block***

Purpose of Well (check one): Home \_\_\_\_\_ Industrial \_\_\_\_\_ Public Supply \_\_\_\_\_ Irrigation  Fish Culture \_\_\_\_\_ Other: \_\_\_\_\_

If a flowing well, method of flow regulation: Valve NA Other (describe) \_\_\_\_\_

Static Water Level: 160' feet above or below (circle one) land surface Date measured: 8-24-05

Method of Measurement (circle one) steel tape electric tape air line other: string weight

Well depth: 240' Well grouted to a depth of 50 feet Type of grout (circle one): Neat Cement Bentonite Mix

Casing length: 230 feet Casing diameter: 4 inches Type of casing: pvc

Screen length: 20 feet Screen diameter: 4 inches Type of screen: pvc

Screen slot size: .010 inches Setting depth: From 230 feet to 240 feet

Type of completion (circle all applicable): Gravel packed Underreamed Telescoped Open hole Natural Development

Other (describe): \_\_\_\_\_

Top of lap pipe or reduction in casing: NA feet. *If telescoped or more than one screen, describe on next page*


Form: OLWR-SWR-1A

**RECEIVED**  
 SEP 26 2005  
 BY: OLWR

G-93

The sketch below only required for water wells


If well telescopes, show depths on sketch.

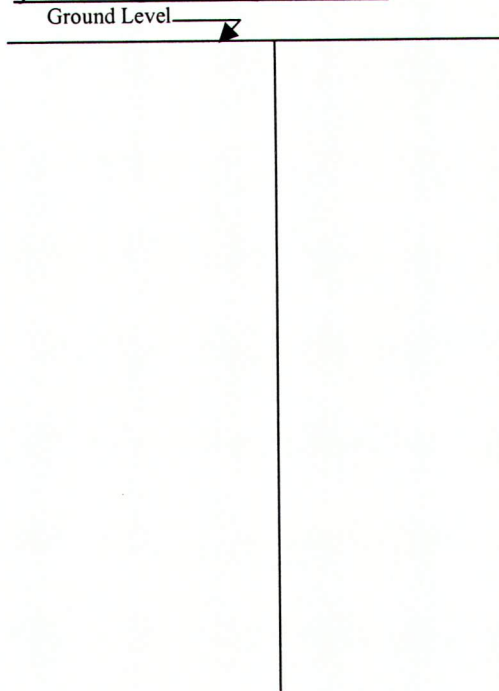

Description of formations encountered must be provided for all wells and boreholes, unless specifically exempted by regulations

Description of Formations Encountered	From (depth)	To (depth)
clay dirt	Ground Level	25
gravel	25	40
Blue clay	40	110
fine white sand	110	240

If more than one screen, show location of each on sketch

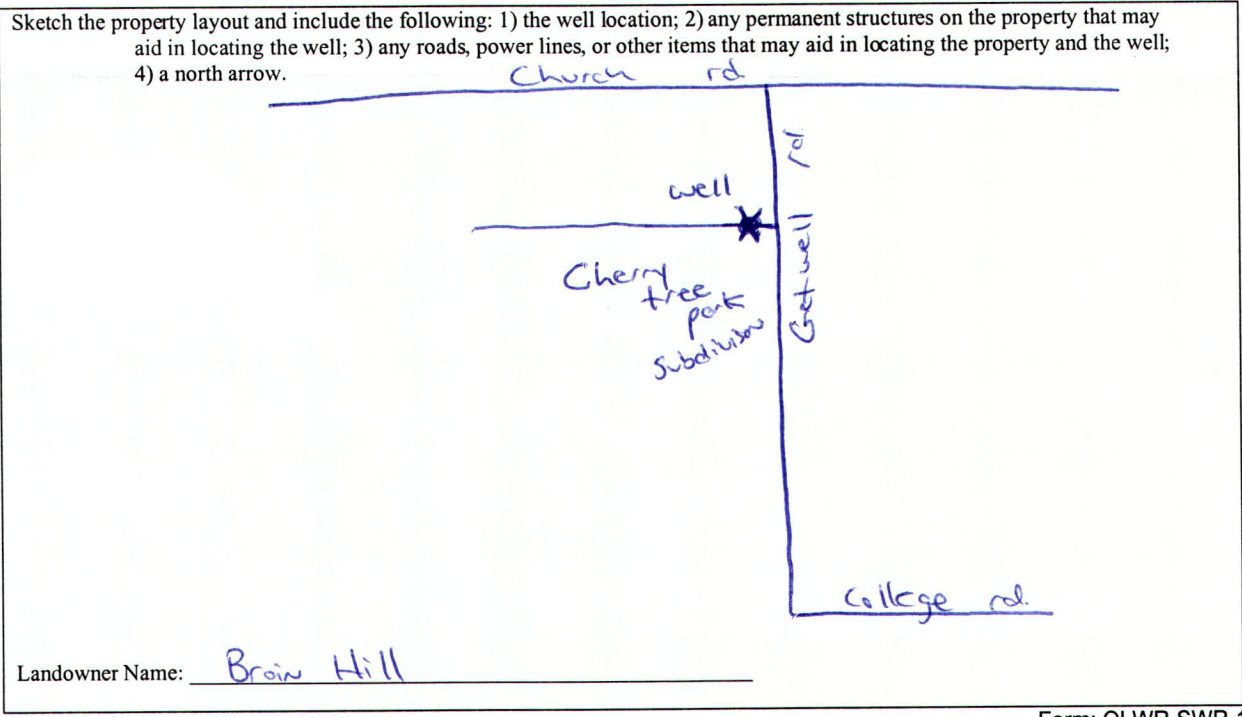

Form: OLWR-SWR-1A

I certify that the well/borehole was drilled, constructed, and completed in accordance with all applicable requirements of the Mississippi Department of Environmental Quality and the Mississippi Department of Health regulations, if applicable, and state laws.

Print Name of Responsible Licensee and License No. James W. Moser 0-620

Date 09-22-05

Signature of Licensee James W. Moser

RECEIVED  
SEP 26 2005  
BY: OLWR

# STATE WELL REPORT

## Part 2

**Pump Installer's Completion Report**  
 Mississippi Department of Environmental Quality  
 Office of Land and Water Resources  
 P.O. Box 10631  
 Jackson, MS 39289-0631  
 (601)961-5210  
 (601)354-6938 (fax)

County: DeSoto  
 Permit #: \_\_\_\_\_  
 Driller: James W. Masou  
 Date completed: 8-24-05  
*Copy information from block on Part 1*

**For Office Use Only:**

Aquifer: \_\_\_\_\_  
 Well #: G-93  
 Elevation: \_\_\_\_\_

*This part of the report must be completed by a licensed water well contractor or a licensed pump installer. A copy of Part 1 of the report must be attached and both parts filed with the Department at the above address within 30 days of well completion.*

Well Owner Information	Well Location
Owner Name: <u>BRAIN HILL</u>	Latitude: <u>34.54.674</u> Longitude: <u>89.56.234</u>
Mailing Address: <u>Cherry tree park subdivision</u> <u>Getwell rd south of church rd</u> <u>Southaven ms 38672</u> City State Zip Code	Method of Lat/Long (check one): Conventional Survey _____ USGS quad _____, Hand-held GPS <input checked="" type="checkbox"/> , Survey-grade GPS _____ <u>SE</u> ¼ <u>NE</u> ¼ Sec <u>9</u> T <u>2s</u> R <u>7w</u>
Telephone No. ( <u>662</u> ) <u>409-7776</u>	Distance Direction Nearest Town <u>3 1/2</u> Miles <u>SE</u> of <u>plum point</u>

Pump Type Circle one	Power Type Circle one
Air Lift Jet <input type="checkbox"/> <b>Submersible</b> <input checked="" type="checkbox"/>	Diesel Engine Gasoline Engine Natural Gas
Bucket Piston Turbine	<b>Electric Motor</b> <input checked="" type="checkbox"/> Hand Tractor PTO
Centrifugal Rotary Flowing Well	Windmill Other (specify): _____
Other (specify): _____	Horse Power Rating of Motor: <u>5 hp</u>
Date Pump Installed: <u>8-24-05</u>	Setting Depth: <u>200'</u> feet
Rated Pump Capacity: <u>60</u> Gallons Per Minute	Number of Stages: <u>16</u>

Pump Test Data	Method of Measuring Water Level Circle one
Date Well Tested: <u>8-24-05</u>	Air Line Electric Measuring Line Steel Tape
Static Water Level (A): <u>160'</u> Feet Below Land Surface	Other (specify): <u>string / weight</u>
Pumping Water Level (B): <u>NA</u> Feet Below Land Surface	For flowing well, measured shut in head: <u>NA</u> feet
Drawdown [(B) - (A)]: <u>NA</u> Feet Below Land Surface	Well yielded <u>60</u> GPM with a drawdown of
Test Pumping Rate: <u>60</u> Gallons Per Minute	<u>NA</u> feet after <u>24</u> hours of pumping
Duration of Pump Test (minimum 4 hours): <u>24</u> hours	

I HEREBY CERTIFY that the above statements are true to the best of my knowledge.

James W. Masou \_\_\_\_\_  
 Print Name of Pump Installer and License No. (if applicable) Signature of Pump Installer

Form: OLWR-SWR-1B  
**RECEIVED**  
**SEP 26 2005**  
**BY: OLWR**