

# State Well Report

## Part 1 - Driller's Log

Mississippi Department of Environmental Quality  
Office of Land and Water Resources  
P.O. Box 10631  
Jackson, MS 39289-0631  
(601)961-5210  
(601)354-6938 (fax)

County: Desoto  
Permit #: \_\_\_\_\_  
Driller: Jones W. Mason  
Date drilling completed: 4-4-07

For Office Use Only:

Aquifer: \_\_\_\_\_  
Well #: G-99  
L. S. Elevation: \_\_\_\_\_  
E-log #: \_\_\_\_\_

**State Law requires that this report be prepared by the license holder responsible for the work and filed with the Department at the above address within 30 days of completion of drilling of the well or borehole.**

Information on Well Owner <small>(Landowner if borehole is not for a water well)</small>	Well or Borehole Location
Owner Name: <u>Don Loasier</u>	Latitude: <u>34° 55' 203"</u> Longitude: <u>89° 54' 586"</u>
Mailing Address: <u>4555 Spring Meadow way S.</u>	Method of Lat/Long (circle one): Conventional Survey, <u>35</u>
<u>Olive Branch MS 38654</u>	USGS quad: <u>Hand-held GPS</u> Survey-grade GPS
City State Zip Code	<u>SE 1/4 SE 1/4 Sec 11 Twn 2S Rng 7W</u>
Telephone No. ( <u>901</u> ) <u>299-9280</u>	Distance Direction Nearest Town <u>314</u> Miles <u>NW</u> of <u>Pleasant Hill</u>

**Well / Borehole Data**

Date drilling started: 4-4-07 Date drilling completed: 4-4-07 Hole depth: 230' Hole diameter: 6 3/4"

Location of the source of any surface water used for drilling: NA

Method of dosing and volume of Chlorine used in drilling and development: NA

Logs run (circle all applicable): No log run Electric Gamma Ray Density Sonic Neutron Other: \_\_\_\_\_

Name of organization running log(s): NA

Purpose of borehole (check one): Water Well  Geotechnical/Geological Investigation \_\_\_ Ground Source Heat Pump \_\_\_

Seismic Survey \_\_\_ Other (describe) \_\_\_\_\_

*If drilling is not related to water well construction, skip the remainder of this block*

Purpose of Well (check one): Home \_\_\_ Industrial \_\_\_ Public Supply \_\_\_ Irrigation  Fish Culture \_\_\_ Other: \_\_\_\_\_

If a flowing well, method of flow regulation: Valve NA Other (describe) \_\_\_\_\_

Static Water Level: 135 feet above or below (circle one) land surface Date measured: 4-13-07

Method of Measurement (circle one) steel tape electric tape air line other: String Weight

Well depth: 230 Well grouted to a depth of 10 feet Type of grout (circle one): Neat Cement Bentonite Mix

Casing length: 210 feet Casing diameter: 4 inches Type of casing: pvc

Screen length: 20 feet Screen diameter: 4 inches Type of screen: pvc

Screen slot size: .010 inches Setting depth: From 210 feet to 230 feet

Type of completion (circle all applicable): Gravel packed Underreamed Telescoped Open hole Natural Development


Other (describe): NA

Top of lap pipe or reduction in casing: NA feet. *If telescoped or more than one screen, describe on next page*

**RECEIVED**  
**MAY 04 2007**  
**BY: OLWR**

The sketch below only required for water wells

If well telescopes, show depths on sketch.

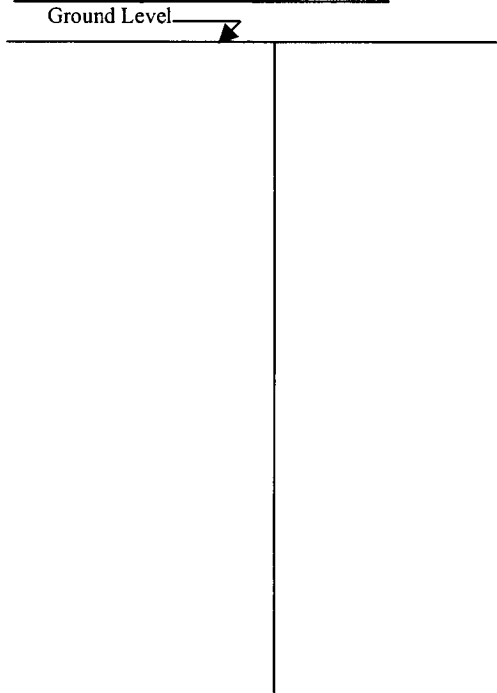

Description of formations encountered must be provided for all wells and boreholes, unless specifically exempted by regulations

Description of Formations Encountered	From (depth)	To (depth)
Clay dirt	Ground Level	25
gravel	25	40
Blue clay	40	180
white sand.	180	230

If more than one screen, show location of each on sketch

Sketch the property layout and include the following: 1) the well location; 2) any permanent structures on the property that may aid in locating the well; 3) any roads, power lines, or other items that may aid in locating the property and the well; 4) a north arrow.



Landowner Name: Don Loasier

RECEIVED  
MAY 04 2007  
BY: OLWR

I certify that the well/borehole was drilled, constructed, and completed in accordance with all applicable requirements of the Mississippi Department of Environmental Quality and the Mississippi Department of Health regulations, if applicable, and state laws.

Jones w. Mason 0-620      5-1-07      Jones W. Mason  
 Print Name of Responsible Licensee and License No.      Date      Signature of Licensee

Form: OLWR-SWR-1A

# STATE WELL REPORT

## Part 2

**Pump Installer's Completion Report**  
 Mississippi Department of Environmental Quality  
 Office of Land and Water Resources  
 P.O. Box 10631  
 Jackson, MS 39289-0631  
 (601)961-5210  
 (601)354-6938 (fax)

County: Desoto  
 Permit #: \_\_\_\_\_  
 Driller: Jones W. Mason  
 Date completed: 4-13-07  
*Copy information from block on Part 1*

**For Office Use Only:**

Aquifer: \_\_\_\_\_  
 Well #: G-99  
 Elevation: \_\_\_\_\_

*This part of the report must be completed by a licensed water well contractor or a licensed pump installer. A copy of Part 1 of the report must be attached and both parts filed with the Department at the above address within 30 days of well completion.*

Well Owner Information	Well Location
Owner Name: <u>Don Loosier</u>	Latitude: <u>34.55.223</u> Longitude: <u>89.54.586</u>
Mailing Address: <u>4555 Spring meadow way S.</u>	Method of Lat/Long (check one): Conventional Survey _____, USGS quad _____, Hand-held GPS <input checked="" type="checkbox"/> , Survey-grade GPS _____
<u>Byhalia</u> MS <u>38654</u>	<u>SE</u> ¼ <u>SE</u> ¼ Sec <u>11</u> T <u>25</u> R <u>7W</u>
City State Zip Code	Distance Direction Nearest Town
Telephone No. <u>(601) 299-9280</u>	<u>3/4</u> Miles <u>NW</u> of <u>pleasant hill</u>

Pump Type Circle one	Power Type Circle one
Air Lift Jet <input type="checkbox"/> <u>Submersible</u> <input checked="" type="checkbox"/>	Diesel Engine Gasoline Engine Natural Gas
Bucket Piston Turbine	<u>Electric Motor</u> <input checked="" type="checkbox"/> Hand Tractor PTO
Centrifugal Rotary Flowing Well	Windmill Other (specify): _____
Other (specify): _____	Horse Power Rating of Motor: <u>3 hp</u>
Date Pump Installed: <u>4-13-07</u>	Setting Depth: <u>160'</u> feet
Rated Pump Capacity: <u>30</u> Gallons Per Minute	Number of Stages: <u>16</u>

RECEIVED  
 MAY 04 2007  
 BY: OLWR

Pump Test Data	Method of Measuring Water Level Circle one
Date Well Tested: <u>4-13-07</u>	Air Line Electric Measuring Line Steel Tape
Static Water Level (A): <u>135</u> Feet Below Land Surface	Other (specify): <u>string / weight</u>
Pumping Water Level (B): <u>30</u> Feet Below Land Surface	For flowing well, measured shut in head: <u>NA</u> feet
Drawdown [(B) - (A)]: <u>NA</u> Feet Below Land Surface	Well yielded <u>30</u> GPM with a drawdown of
Test Pumping Rate: <u>NA</u> Gallons Per Minute	<u>NA</u> feet after <u>24</u> hours of pumping
Duration of Pump Test (minimum 4 hours): <u>24</u> hours	

I HEREBY CERTIFY that the above statements are true to the best of my knowledge.

Jones W. Mason 0-620  
 Print Name of Pump Installer and License No. (if applicable)

Jones W. Mason  
 Signature of Pump Installer