State Well Report				
County: Desoto	Part 1 – Driller's Log		For Office Use Only:	
-		t of Environmental Quality	Aquifer:	
Permit #:	Office of Land and Water Resources P.O. Box 2309		Well #:	
Driller: Janes w. Mason		, MS 39225	L. S. Elevation:	
Date drilling completed: 3-19-12	\- · · /	961- 5210 - 5228 (fax)		
	, ,	, ,	E-log #:	
State Law requires that this report Department at the above address	t be prepared by the lice within 30 days of comm	ense holder responsible for the letion of drilling of the well	ne work ana juea wun ine or borehole.	
Information on Well ()wner	Well or Bo	rehole Location	
(Landowner if borehole is not fo	or a water well)	Latitude: 34 . 29 ,059	" Langitude: 88 990 , 461"	
Owner Name Tracy welch		Latitude: 34 ° 29 ° 059 " Longitude: 88 ° 90 ° 961" 53 26 Method of Lat/Long (circle one): Conventional Survey,		
Mailing Address: 4845 pleas	at hill rd	Method of Lat/Long (circle one): Conventional Survey,		
Mailing Address: 0 73 prees	00. , <u>, , , , , , , , , , , , , , , , , ,</u>	USGS quad, Hand-held	GPS Survey-grade GPS	
		38 4 38 4 Sec 23	Twn 25 Rng TW	
Nesbit M	√5 3862€			
City Sta	te Zip Code	Distance Direction	of <u>pleasant hill</u>	
Telephone No. (662) 587 - 1101				
	Weil / Bore	hole Data		
2			Wala diamatan (63) y	
Date drilling started: 3-19-12 Date dr	illing completed: 3-19	Hole depth:	Hole diameter:	
Location of the source of any surface wat	er used for drilling:	IA		
Method of dosing and volume of Chlorin	e used in drilling and deve	opment: $^{1/4}$		
Logs run (circle all applicable): No log run Electric Gamma Ray Density Sonic Neutron Other:				
Purpose of borehole (check one): Water Well Geotechnical/Geological Investigation Ground Source Heat Pump				
Seismic SurveyOther (describe)//-				
If drilling is not related to water well construction, skip the remainder of this block				
Purpose of Well (check one): Home Industrial Public Supply Irrigation Fish Culture Other:				
If a flowing well, method of flow regulation: Valve Other (describe)				
Static Water Level: 120 feet above or below (circle one) land surface Date measured: 3-20-12				
Method of Measurement (circle one) steel tape electric tape air line other: 5 tring lastice				
Well depth: 210' Well grouted to a depth of 10 feet Type of grout (circle one): Neat Cement Bentonite Mix				
Casing length: 190 feet Casing diameter: 4 inches Type of casing:				
Screen length: <u>JO</u> feet Scr			1	
Screen slot size: . O 10 inches Setting depth: From 190 feet to 310 feet				
Type of completion (circle all applicable): Gravel packed Underreamed Telescoped Open hole Natural Development				
Other (describe):				
Top of lap pipe or reduction in casing:				

RECEIVED

APR 1 9 2012

BY: OLWR

The sketch below only required for water wells


If well telescopes, show depths on sketch.

Ground Level_____

Description of forma	<u>tions encountered</u>	<u>must be provided</u>	<u>d for all</u>
wells and boreholes,	unless specifically	exempted by reg	ulations

From (depth)	To (depth)
Ground Level	3.3
3∂ _	60
60	160
160	210
	_
	60

If more than one screen, show location of each on sketch

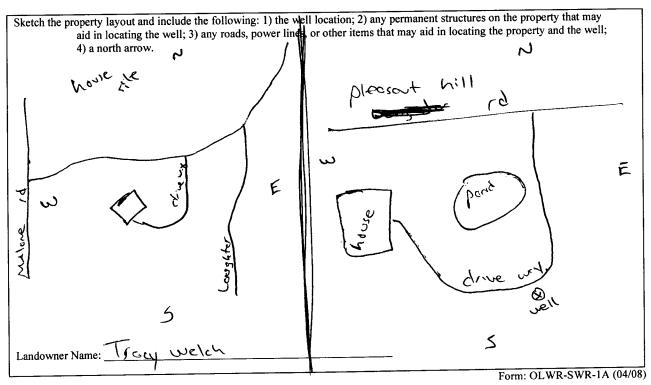

I certify that the well/borehole was drilled, constructed, and completed in accordance with all applicable requirements of the Mississippi Department of Environmental Quality and the Mississippi Department of Health regulations, if applicable, and state

Jones w. Maxin 0-620	4-16-12	Gas w. Masn.	RECEIVED
Print Name of Responsible Licensee and License No.	Date	Signature of Licensee	APR 1 9 2012

BY: OLWR

STATE WELL REPORT

Permit #: ______ Driller: 5000 w Mason Date completed: 3 - 20 - 12

Copy information from block on Part 1

Part 2

Pump Installer's Completion Report
Mississippi Department of Environmental Quality
Office of Land and Water Resources
P.O. Box 2309
Jackson, MS 39225
(601)961-5210

(601)961-5228 (fax)

For Office Use Only:			
Aquifer:			
Well #:	Glaa		
Elevation:			

This part of the report must be completed by a licensed water well contractor or a licensed pump installer. A copy of Part I of the report must be attached and both parts filed with the Department at the above address within 30 days of well completion.

Well Owner Information

Owner Name: Tracy welch

Mailing Address: 4845 pleasant will rd

Method of Lat/Long (check one): Conventional Survey.

USGS quad..., Hand-held GPS..., Survey-grade GPS...

USGS quad..., Hand-held GPS..., Survey-grade GPS...

Distance Direction Nearest Town

Telephone No. (662) 587-1101

Telephone No. (662) 587-1101

Pump Type Circle one		Power Type Circle one			
Air Lift	Jet	Submersible	Diesel Engine	Gasoline Engine	Natural Gas
Bucket	Piston	Turbine	Electric Motor	Hand	Tractor PTO
Centrifugal	Rotary	Flowing Well	Windmill	Other (specify):	
Other (specify):			Horse Power Rating	of Motor: 11/2	
Date Pump Installed:	3-20-12		Setting Depth:	160	feet
Rated Pump Capacity:	97	_Gallons Per Minute	Number of Stages: _	11	

Method of Measuring Water Level **Pump Test Data** Circle one Date Well Tested: _ 3-20-12 Steel Tape Electric Measuring Line Air Line Static Water Level (A): 120 Feet Below Land Surface Other (specify): String weight Pumping Water Level (B): NA Feet Below Land Surface Drawdown [(B) - (A)]: ______Feet Below Land Surface For flowing well, measured shut in head: ______feet Well yielded $\partial \mathbf{\lambda}$ GPM with a drawdown of Test Pumping Rate: ______ Gallons Per Minute feet after 34 hours of pumping Duration of Pump Test (minimum 4 hours): $\frac{\partial Y}{\partial x}$ hours

I HEREBY CERTIFY that the above statements are true to the best	of my knowledge.	
Jones W. Moson 0-620	gas as Mun	RECEIVED
Print Name of Pump Installer and License No. (if applicable)	Signature of Pump Installer Form: Ol	-WR-SWRPR (94908)012