

MISSISSIPPI DEPARTMENT OF NATURAL RESOURCES

Bureau of Land and Water Resources

Southport Mall

P.O. Box 10631

Jackson, Mississippi 39209

WATER WELL DRILLERS LOG

De Soto
G 1999

6-28-19
date well completed

~~C&F Contracting Co~~
Wilson Inc.
firm name

De Soto
county well located

LANDOWNER:

C&F Contracting Company
Tupelo MS
(mailing address)

WELL LOCATION:

sec. 26 T. 2 N. R. 7 E.
S W
5 miles East of Nesbit
(distance) (direction) (nearest town)

WELL PURPOSE:

(home, irrigation, municipal, industrial)

WELL COMPLETION DATA:

- (1) diameter (inches) 12"
 - (2) total depth (feet) 338'
 - (3) static water level (feet) _____ below
top of ground.
 - (4) casing steel, 252',
(material) (depth)
12" if telescope see back.
(size)
 - (5) screen 60', 278'
(length) (depth to top)
8', stainless steel
(size) (material)
 - (6) pump 25 1200
(HP) (yield gpm)
VHS 460v.
(type power)
 - (7) electric log No
(yes or no)
- (organization running log)

(8) how well bottom plugged Cement Plug

description of formations encountered

from to

Clay	0	10
Gravel	10	58
Blue Clay	58	122
Sand (Fine)	122	202
Sand (Coarse)	202	222
Blue Clay & Sand	222	247
White Sand (Med-Fine)	247	310
White Sand (Med-Coarse)	310	340

DEPT. OF NATURAL RESOURCES
BUREAU OF LAND & WATER RESOURCES



AUG 2 1984

RECEIVED

DRILLERS REMARKS:

If well telescopes please sketch and show depths.

GROUND LEVEL

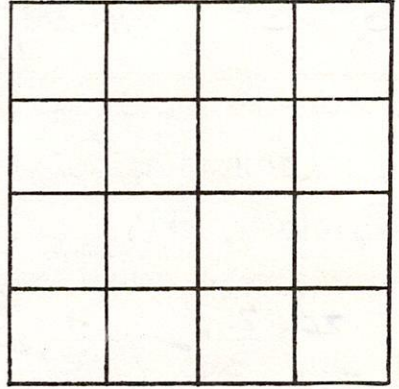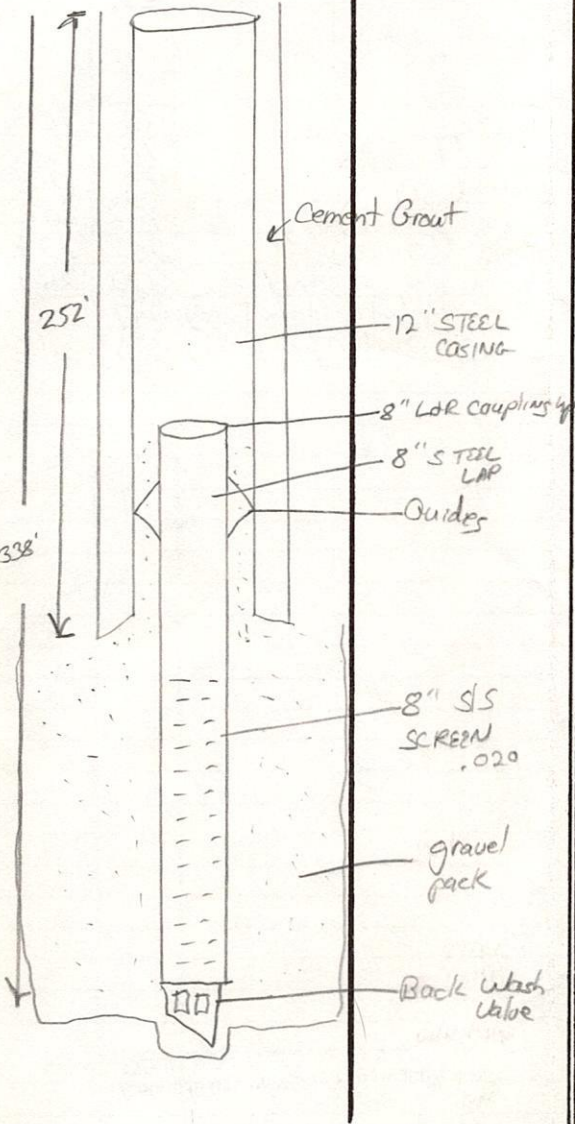

SECTION _____

Please indicate well location X.

ADDITIONAL INFORMATION

If more than one screen, show locations of each on sketch.