

Desoto MISSISSIPPI BOARD OF WATER COMMISSIONERS

G 2000
2-14-63

WATER WELL DRILLERS LOG

Date: 2/14, 19 63, Driller: Deep South Well Co. County DeSoto
(Name)

1) Owner of Land: <u>C. W. Tarter</u> (Name)	Description & Color of Materials Sand, Clay, Red Clay, Shell, etc.	Thick- ness Feet	Depth Feet
<u>Rural Route, Nesbit, Miss.</u> (Address)	0-25 Surface clay	25	
(2) Location: <u>1/4, 1/4, Sec. 13 T2R9</u>	25-30 Red sand	5	
<u>1/4</u> miles <u>West</u> , of <u>Pleasant Hill</u> (distance) (direction) (Nearest Town)	30-35 Gravel	5	
(3) Topography: <u>Hilly</u> (Hilly) (Flat) (Level)	35-45 Yellow clay, lignite	10	
(4) Purpose of Well: <u>Domestic</u> (Domestic Irrigation Municipal, Industrial, Other)	45-120 Sticky blue clay	75	
	120-175 Fine sand	55	
	175-186 Med. coarse sand	11	


Information upon completion of well:

- (1) Diameter 2 1/8 inches.
- (2) Total Depth 186 feet.
- (3) Water Level 121 feet below top of ground.
- (4) Cased to None, Size None.
- (5) Screen: Size 1 1/2", Length 8 ft.
- (6) Were any formations sealed against pollution?
no yes, No no.

If YES depth of formation _____

Why _____

Drillers Remarks: _____

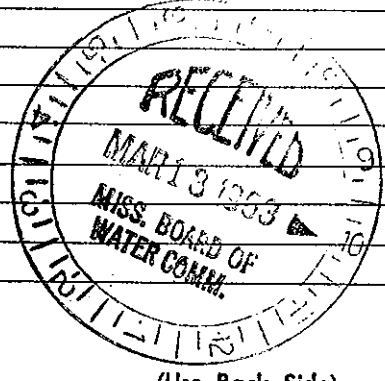

(Use Back Side)

Well No.

Mail this copy to Board of Water Commissioners 429 Miss. St. Jackson, Miss.