

Desoto MISSISSIPPI BOARD OF WATER COMMISSIONERS

H34

0132

4-15-64

WATER WELL DRILLERS LOG **CODED**

Date: 4-15-64, Driller: Layne-Central Co. County DeSoto

(Name)

(1) Owner of Land: Fairhaven Water Assn.
 (Name)
 Olive Branch, Mississippi
 (Address)

(2) Location: 1/4, 1/4, Sec. 1 T. 5 R. 4
 (distance) (direction) (Nearest Town)

(3) Topography: _____
 (Hilly) (Flat) (Level)

(4) Purpose of Well: municipal
 (Domestic Irrigation
 Municipal, Industrial, Other)

Description & Color of Materials Sand, Clay, Red Clay, Shell, etc.	Thick- ness Feet	Depth Feet
clay	10	0
sand-gravel	44	10
clay	10	154
sand-sts. clay	6	160
pk sand	17	177
clay	3	180
sand and clay	23	203
sand and clay	23	226
soft sts.	3	229
pk sand-soft sts.	19	248
pk sand	24	272
pk sand	18	290

Information upon completion of well:

(1) Diameter 8 inches.

(2) Total Depth 291' 3" feet.

(3) Water Level 129 feet below top of ground.

(4) Cased to 254', Size 8"


(5) Screen: Size 6", Length 9' 7"

(6) Were any formations sealed against pollution?
 yes, _____ no.

CODED

If YES depth of formation 254'
 Why _____ required

Drillers Remarks: _____

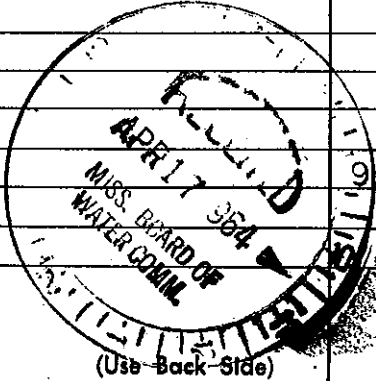

Well No.

this copy to Board of Water Commissioners 429 Miss. St. Jackson, Miss.