

DeSoto

MISSISSIPPI BOARD OF WATER COMMISSIONERS

H 41

WATER WELL DRILLERS LOG

4-300  
**CODED**


7-21-60

Date: July 21, 19 60, Driller: Deep South Well Co. County DeSoto

(Name)

(1) Owner of Land: <u>David Harrison, Jr.</u>	Description & Color of Materials Sand, Clay, Red Clay, Shell, etc.	Thick- ness Feet	Depth Feet
(Name)	0-17 Surface Clay	17	
4569 Ridgewood Rd., Memphis, Tenn. (Address)	17-35 Red Sand, some gravel	18	
(2) Location: <u>1/4</u> , <u>1/4</u> , Sec. <u>8</u> T <u>2</u> R <u>5</u> ,	35-91 White clay, sand	56	
<u>1/2</u> miles <u>S.E.</u> , of <u>Miller, Miss.</u> (distance) (direction) (Nearest Town)	91-124 Fine sand strks	33	
(3) Topography: <u>Sloping</u> (Hilly) (Flat) (Level)	124-142 Med fine, some med.	18	
(4) Purpose of Well: <u>Domestic</u> (Domestic Irrigation Municipal, Industrial, Other)	142-153 Coarse & med coarse	11	

**CODED**

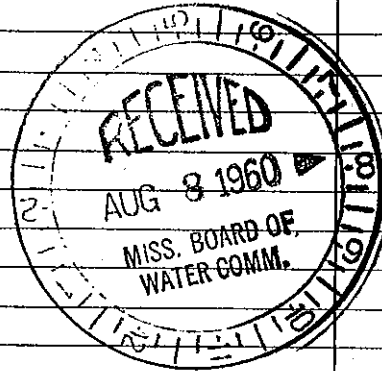

Information upon completion of well:

- (1) Diameter 3 inches.
- (2) Total Depth 153 feet.
- (3) Water Level 55 feet below top of ground.
- (4) Cased to None, Size \_\_\_\_\_
- (5) Screen: Size 2"-006, Length 6 ft  
slot
- (6) Were any formations sealed against pollution?  
no yes, No no.

If YES depth of formation \_\_\_\_\_

Why \_\_\_\_\_

Drillers Remarks: None

Well No.

(Use Back Side)

Mail this copy to Board of Water Commissioners 429 Miss. St. Jackson, Miss