

MISSISSIPPI BOARD OF WATER COMMISSIONERS

DeSoto
H 43
10-12-60

WATER WELL DRILLERS LOG

D 7
CODED

Date: Oct. 12, 1960, Driller: Deep South Well Co. County: DeSoto
(Name)

(1) Owner of Land: Tom C. Seago
(Name)
Rural Rte., Byhalia, Miss.
(Address)

(2) Location: 1/4, 1/4, Sec. 6 T. 3 R. 5,
4 1/2 miles N.W. of Byhalia
(distance) (direction) (Nearest Town)

(3) Topography: Hilly
(Hilly) (Flat) (Level)

(4) Purpose of Well: Domestic
(Domestic Irrigation
Municipal, Industrial, Other)

Description & Color of Materials Sand, Clay, Red Clay, Shell, etc.	Thick- ness Feet	Depth Feet
<u>0-15 Surface clay</u>	<u>15</u>	
<u>15-60 Red sand & clay</u>	<u>45</u>	
<u>60-85 Coarse clean sand, some gravel</u>	<u>25</u>	
<u>85-95 Med. fine sand</u>	<u>10</u>	
<u>95-129 Med. coarse sand</u>	<u>34</u>	
<u>129-135 Med. Coarse, some coarse</u>	<u>6</u>	
<u>135-143 Coarse sand</u>	<u>8</u>	

Information upon completion of well:

(1) Diameter 3 inches.

(2) Total Depth 143 feet.

(3) Water Level 119 feet below top of ground.

(4) Cased to None, Size _____

(5) Screen: Size 2", Length 8 ft


(6) Were any formations sealed against pollution?
_____ yes, No no.

If YES depth of formation _____

Why _____

Drillers Remarks: None

CODED

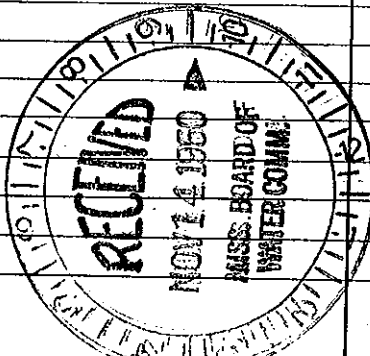

(Use Back Side)

Well No.

Mail this copy to Board of Water Commissioners 429 Miss. St. Jackson, Miss.