

DeSoto

MISSISSIPPI BOARD OF WATER COMMISSIONERS

CODED

H 45

WATER WELL DRILLERS LOG

4-3-63

Date: 4-3, 1963, Driller: Deep South Well Co. County DeSoto
(Name)


(1) Owner of Land: <u>Deroy McIngvale</u> (Name)	Description & Color of Materials Sand, Clay, Red Clay, Shell, etc.	Thick- ness Feet	Depth Feet
<u>Rural Route, Olive Branch, Miss.</u> (Address)	0-15 <u>Surface clay</u>	15	
(2) Location: <u>1/4</u> , <u>1/4</u> , Sec. <u>15 T2R6</u> , <u>in town of Cedar View, Miss.</u> miles (distance) of (Nearest Town)	15-55 <u>Sand & Gravel</u>	40	
(3) Topography: <u>Hilly</u> (Hilly) (Flat) (Level)	55-90 <u>White clay, sand</u>	35	
(4) Purpose of Well: <u>Domestic</u> (Domestic Irrigation Municipal, Industrial, Other)	90-119 <u>Fine sand</u> <u>strks</u> <u>'clay strks</u>	29	
	119-128 <u>Fine sand</u>	9	
	128-149 <u>Med. Fine sand</u>	21	
	149-160 <u>White clay</u>	11	
	160-180 <u>Fine sand</u>	20	
	180-187 <u>Med. coarse, some</u> <u>coarse sand</u>	7	

Information upon completion of well:

- (1) Diameter 2 inches.
- (2) Total Depth 187 feet.
- (3) Water Level 113 feet below top of ground.
- (4) Cased to None, Size None.
- (5) Screen: Size 1 1/4", Length 6 ft.
- (6) Were any formations sealed against pollution?
no.

If YES depth of formation _____
Why _____
Drillers Remarks: _____

CODED

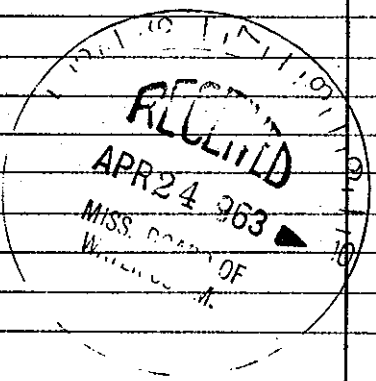

(Use Back Side)

Well No.