

Desoto MISSISSIPPI BOARD OF WATER COMMISSIONERS

H 46

12-19-64

WATER WELL DRILLERS LOG

CODED

Date: 12/19, 1964, Driller: Thorpe Well Supply County: Desoto
(Name)

(1) Owner of Land: Dennis L. Carter
(Name)
Olive Branch Miss
(Address)
 (2) Location: 1/4, 1/4, Sec. 29 T. 2 R. 6,
1 miles North, of Lewisburg,
(distance) (direction) (Nearest Town)
 (3) Topography: Hilly
(Hilly) (Flat) (Level)
 (4) Purpose of Well: Domestic
(Domestic Irrigation Municipal, Industrial, Other)


Description & Color of Materials Sand, Clay, Red Clay, Shell, etc.	Thick- ness Feet	Depth Feet
Top Soil	5	0-5
Red Clay	10	5-15
Red Sand	15	30
Gravel + Sand	15	45
Blue Clay	64	109
Rock	1	110
Blue Clay	5	115
Hard Rock	1	116
Blue Clay	69	175
sand	27	202

Information upon completion of well:

(1) Diameter 4 inches.
 (2) Total Depth 202 feet.
 (3) Water Level 100 feet below top of ground.
 (4) Cased to 202, Size 4"
 (5) Screen: Size 6", Length 4"
 (6) Were any formations sealed against pollution?
 yes, no.

If YES depth of formation 64
 Why Pollution
 Drillers Remarks:

CODED

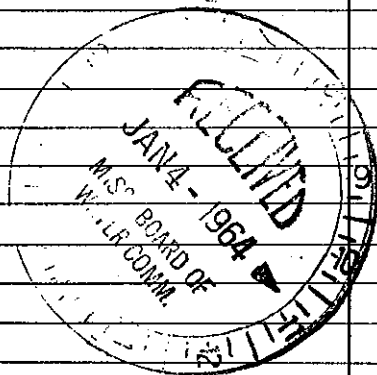

Well No.

(Use Back Side)