

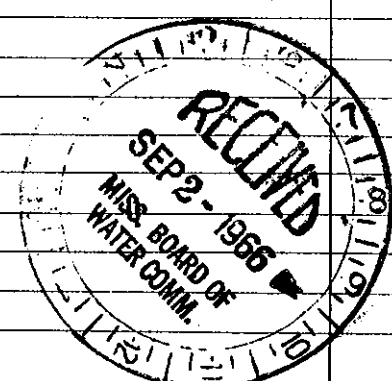
Desoto MISSISSIPPI BOARD OF WATER COMMISSIONERS

H 47

8-9-66

WATER WELL DRILLERS LOG

Date: Aug 9, 1966, Driller: Miller **CODED** Deep South Desoto
(Name) County

	Description & Color of Materials Sand, Clay, Red Clay, Shell, etc.	Thick- ness Feet	Depth Feet
(1) Owner of Land: <u>Harold Bell</u> <small>(Name)</small> <u>Byhalia, Miss.</u> <small>(Address)</small>	<u>0-25 surface clay</u>	<u>25</u>	
(2) Location: <u>1/4, 1/4, Sec. 21 T 2 R 5</u>	<u>25-60 red sand, sandstone</u>	<u>35</u>	
<u>3 1/2</u> miles <u>N.E.</u> of <u>Byhalia</u> <small>(distance) (direction) (Nearest Town)</small>	<u>60-119 fine sand</u>	<u>59</u>	
(3) Topography: <u>Hilly</u> <small>(Hilly) (Flat) (Level)</small>	<u>119-128 med. coarse sand</u>	<u>9</u>	
(4) Purpose of Well: <u>Domestic</u> <small>(Domestic Irrigation Municipal, Industrial, Other)</small>			
Information upon completion of well:			
(1) Diameter <u>2 1/2</u> inches.	CODED		
(2) Total Depth <u>128</u> feet.			
(3) Water Level <u>8.5</u> feet below top of ground.			
(4) Cased to <u>121</u> , Size <u>2 1/2</u>			
(5) Screen: Size <u>1 1/2"</u> , Length <u>7'</u>			
(6) Were any formations sealed against pollution? <u>no</u>			
If YES depth of formation _____			
Why _____			
Drillers Remarks: _____			

_____	Well No.		

(Use Back Side)

Mail this copy to Board of Water Commissioners 429 Miss. St. Jackson, Miss