

Desoto
H 51
9-67

MISSISSIPPI
BOARD OF WATER COMMISSIONERS
416 North State Street
Jackson, Mississippi 39201

CODED

WATER WELL DRILLERS LOG

9-8 1967 date well completed
Robert Wilson firm name
Desoto Marshall county well located

LANDOWNER: J. D. Herrington
Byhalia Miss.
(mailing address)

| description of formations encountered | from | to |
|---------------------------------------|------|-----|
| Red clay Red Sand | 0 | 20 |
| Red Sand Gravel | 20 | 30 |
| Gravel + White Sand | 30 | 60 |
| White Sand | 60 | 130 |

WELL LOCATION:
sec. 30 T 2 N R 5 E
Exact location unknown
miles of (nearest town)
1 Mi. N Stoneville

WELL PURPOSE:
(home, irrigation, municipal, industrial)

WELL COMPLETION DATA:

(1) diameter (inches) 4"

(2) total depth (feet) 130'

(3) static water level (feet) 60' below top of ground

(4) casing Plastic 126' (material) (depth)
4" (size) If telescope see back.


(5) screen 4" 126' (length) (depth to top)
4" Gravel pack (size) (material)

(6) pump 1/2 10 (HP) (yield gpm)
Elect. (type power)

(7) electric log (yes or no)
(organization running log)

(8) how well bottom plugged 4"
Plastic cap

CODED

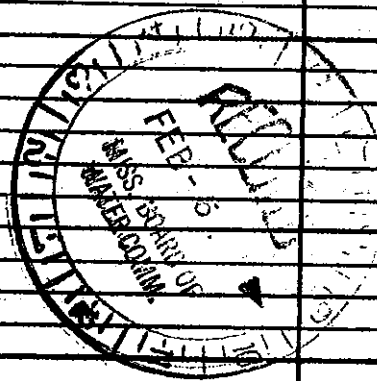

DRILLERS REMARKS: