

DESOYA
H52
9-67

MISSISSIPPI
BOARD OF WATER COMMISSIONERS
416 North State Street
Jackson, Mississippi 39201

CODED

WATER WELL DRILLERS LOG

9-20 1967 Lewis Well Co De Soto
date well completed firm name county well located

LANDOWNER:

James Payne

description of formations encountered

from to

Byholie, Miss
(mailing address)

Surface clay - 1 18
sand gravel 18 50
Blue clay - 50 110
Thin W. Sand 110 128
Water Bearing Sand 128 140

WELL LOCATION:

sec 21 T 2 N R 5 E
2 1/2 miles West of Byholie
(distance) (direction) (nearest town)


WELL PURPOSE:

home
(home, irrigation, municipal, industrial)

WELL COMPLETION DATA:

- (1) diameter (inches) 4"
- (2) total depth (feet) 140
- (3) static water level (feet) 170 below above top of ground.
- (4) casing Plastic 134'
(material) (depth)
(size) If telescope see back.
- (5) screen 6' 134'
(length) (depth to top)
4" Plastic
(size) (material)
- (6) pump 3/4 15
(HP) (yield gpm)
Elec 220V.
(type power)
- (7) electric log no
(yes or no)

CODED

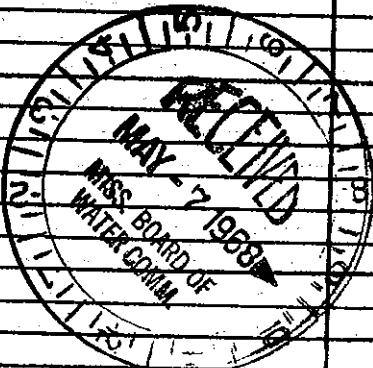

(organization running log)

(8) how well bottom plugged Plastic Plug

DRILLERS REMARKS:

Good Water Supply