

DESOTA  
 H 54  
 11-67

MISSISSIPPI  
 BOARD OF WATER COMMISSIONERS  
 416 North State Street  
 Jackson, Mississippi 39201

**CODED**

WATER WELL DRILLERS LOG

11-15 1967 *Lords Well Co* *De Soto*  
 date well completed firm name county well located

LANDOWNER:

*James M. McClinton*

*Byhalia Miss*  
 (mailing address)

WELL LOCATION:

sec. 21 T. 2 N. R. 5 E.  
*2 1/2* miles *West* of *Byhalia*  
 (distance) (direction) (nearest town)

WELL PURPOSE:

(home, irrigation, municipal, industrial)

WELL COMPLETION DATA:


- (1) diameter (inches) 4"
- (2) total depth (feet) 136
- (3) static water level (feet) 116 below above top of ground.
- (4) casing Plastic, 130  
 (material) (depth)  
 (size) If telescope see back.
- (5) screen 6', 130  
 (length) (depth to top)  
6', Plastic  
 (size) (material)
- (6) pump 1/2, 10  
 (HP) (yield gpm)  
Elec - 220V  
 (type power)
- (7) electric log no  
 (yes or no)  
 (organization running log)
- (8) how well bottom plugged Plastic

description of formations encountered

from to

<i>Surface Clay</i>	<i>1</i>	<i>18</i>
<i>Sand + gravel</i>	<i>18</i>	<i>52</i>
<i>Blue clay</i>	<i>52</i>	<i>112</i>
<i>Thin Sand</i>	<i>112</i>	<i>126</i>
<i>Coarse Water Bearing</i>	<i>126</i>	<i>136</i>

**CODED**

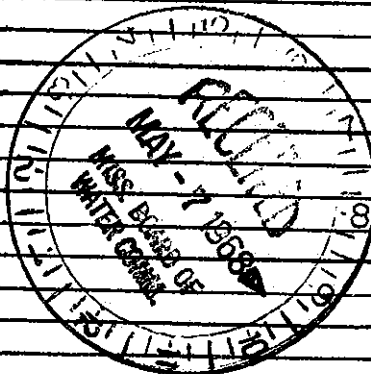

DRILLERS REMARKS:

*Good Water Supply*