

DESOTO  
H55  
~~12-5-67~~

MISSISSIPPI  
BOARD OF WATER COMMISSIONERS  
416 North State Street  
Jackson, Mississippi 39201

**CODED**

WATER WELL DRILLERS LOG

12-5-67 1968 date well completed  
Harris Bros. Desoto firm name  
Desoto county well located

LANDOWNER: Bob Carter  
Olive Branch  
Rt. 2  
(mailing address)

description of formations encountered	from	to
top soil	0	15
pea gravel + sand	15	45
white clay	45	60
green clay	60	120
clay + sand	120	160
coarse sand	160	180


WELL LOCATION:  
sec 34 T12N R6E  
1/2 miles S of Olive Branch  
(distance) (direction) (nearest town)

WELL PURPOSE: home  
(home, irrigation, municipal, industrial)

WELL COMPLETION DATA:

- (1) diameter (inches) 4
- (2) total depth (feet) 180
- (3) static water level (feet) 100 <sup>below</sup> top of ground.
- (4) casing Plastic, 166 (material) (depth)  
4' (size) if telescope see back.
- (5) screen 14' (length), 1166 (depth to top)  
.008 Plastic (size) (material)
- (6) pump 3/4 (HP), 10 (yield gpm)  
elec. (type power)
- (7) electric log NO (yes or no)  
(organization running log)
- (8) how well bottom plugged truck shot

**CODED**

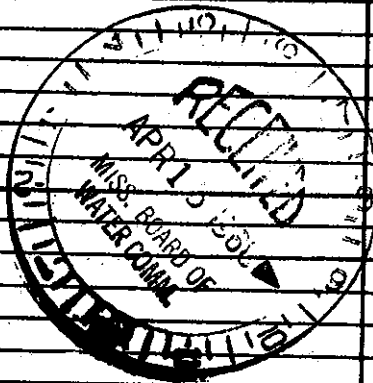

DRILLERS REMARKS: