

County: Desoto
 Permit #: _____
 Driller: James W. Mason
 Date drilling completed: 11-7-04

Well Driller Report and Well Log

Mississippi Department of Environmental Quality
 Office of Land and Water Resources
 P.O. Box 10631
 Jackson, MS 39289-0631
 (601)961-5210
 (601)354-6938 (fax)

For Office Use Only:
 Aquifer: _____
 Well #: H-135 **33**
 L. S. Elevation: _____
 E-log #: _____

State Law requires that this report be prepared by the driller in detail and filed with the Department within 30 days of completion of drilling of the well.

Well Owner Information	Well Location
Owner Name <u>Jason Francis</u>	Latitude: <u>34° 52' 03"</u> Longitude: <u>089° 45' 06"</u>
Mailing Address: <u>LOT #9 Jones place subdiv</u>	Method of Lat/Long (circle one): <u>Conventional Survey</u>
<u>Jonestowne Lane</u>	USGS quad, <u>Hand-held GPS</u> , Survey-grade GPS
<u>Byhalia</u> MS <u>38611</u>	<u>S66</u> 1/4 <u>NE</u> 1/4 Sec <u>31</u> Twn <u>25</u> Rng <u>5w</u>
City State Zip Code	NW SE Direction Nearest Town
Telephone No. <u>(662) 838-2182</u>	<u>1 1/2</u> Miles <u>N</u> of <u>stonewall</u>

Well Data

Purpose of Well (circle one) Home Industrial Public Supply Irrigation Fish Culture Other: _____

Date well drilling started: 11-7-04 Date well drilling completed: 11-7-04

If flowing, method of flow regulation: Valve NA Other (describe) _____

Static Water Level: 45 feet above or below (circle one) land surface Date measured: 11-17-04

Method of Measurement (circle one) steel tape electric tape air line other: String weight

Hole depth: 90' Well depth: 90' Well grouted to a depth of 10 feet

Type of grout (circle one): Cement Bentonite Mix

Casing length: 80 feet Casing diameter: 4 inches Type of casing: 4

Screen length: 10 feet Screen diameter: 4 inches Type of screen: pvc

Screen slot size: .010 inches Setting depth: From 80 feet to 90 feet

Type of completion (circle all applicable): Gravel packed Underreamed Telescoped Open hole Natural Development

Other (describe): _____

Top of lap pipe or reduction in casing: NA feet. If telescoped or more than one screen, describe on back of page

Logs run (circle all applicable): No log run Electric Gamma Ray Density Sonic Neutron Other: _____

Name of organization running log(s): _____

I certify that the well was drilled, constructed, and completed in accordance with all applicable requirements of the Mississippi Department of Environmental Quality and/or the Mississippi Department of Health regulations and state laws.

James W. Mason 0-620 James W. Mason
 Print Name of Water Well Contractor and License No. Signature of Water Well Contractor

If well telescopes please sketch below and show depths.

RECEIVED

NOV 16 2004

BY: ODWR

STATE WELL REPORT

Part 2

Pump Installer's Completion Report
 Mississippi Department of Environmental Quality
 Office of Land and Water Resources
 P.O. Box 10631
 Jackson, MS 39289-0631
 (601)961-5210
 (601)354-6938 (fax)

County: Desoto
 Permit #: _____
 Driller: James W. Mason
 Date completed: 11-17-04

For Office Use Only:

Aquifer: _____
 Well #: H-135 33
 Elevation: _____

This report should be prepared by the pump installer in detail and filed with the Department within 30 days of the installation of pump.

Well Owner Information	Well Location
Owner Name: <u>Jason Francis</u>	Latitude: <u>34-52-023</u> Longitude: <u>089-45-966</u>
Mailing Address: <u>LOT # 9 James place subdivision</u> <u>Jamestowne Lane</u>	Method of Lat/Long (circle one): Conventional Survey, USGS quad, <u>Hand-held GPS</u> Survey-grade GPS
<u>Bilhalia</u> <u>ms</u> <u>3864</u>	<u>SW</u> 1/4 <u>NE</u> 1/4 Sec <u>31</u> Twn <u>25</u> Rng <u>5w</u>
City State Zip Code	Distance Direction Nearest Town
Telephone No. <u>(662) 838-2182</u>	<u>1/2</u> Miles <u>N</u> of <u>stonewall</u>

Pump Type Circle one	Power Type Circle one
Air Lift Jet <u>Submersible</u>	Diesel Engine Gasoline Engine Natural Gas
Bucket Piston Turbine	<u>Electric Motor</u> Hand Tractor PTO
Centrifugal Rotary Flowing Well	Windmill Other (specify): _____
Other (specify): _____	Horse Power Rating of Motor: <u>3/4</u>
Date Pump Installed: <u>11-17-04</u>	Setting Depth: <u>80</u> feet
Rated Pump Capacity: <u>12</u> Gallons Per Minute	Number of Stages: <u>11</u>

Pump Test Data	Method of Measuring Water Level Circle one
Date Well Tested: <u>11-17-04</u>	Air Line Electric Measuring Line Steel Tape
Static Water Level (A): <u>45</u> Feet Below Land Surface	Other (specify): <u>string/weight</u>
Pumping Water Level (B): <u>NA</u> Feet Below Land Surface	For flowing well, measured shut in head: <u>NA</u> feet
Drawdown [(B) - (A)]: <u>NA</u> Feet Below Land Surface	Well yielded <u>12</u> GPM with a drawdown of
Test Pumping Rate: <u>12</u> Gallons Per Minute	<u>NA</u> feet after <u>24</u> hours of pumping
Duration of Pump Test (minimum 4 hours): <u>24</u> hours	

I HEREBY CERTIFY that the above statements are true to the best of my knowledge.

James W. Mason James W. Mason
 Print Name of Pump Installer and License No. (if applicable) Signature of Pump Installer

RECEIVED

033 H-135

topozone



Take this map

- VIEW MAPS
- GET DATA
- MY TOPOZONE
- WEB SERVICES
- ABOUT US

34° 52' 23"N, 89° 46' 36"W (WGS84/NAD83)

USGS Lewisburg Quad

View *TopoZone Pro* aerial photos, shaded relief, street maps, interactive coordinate display, and elevation data

Map/Photo Info

Topo Download

Photo Download

USGS Topo Maps

- 1:24K/25K Series
- 1:100K Series
- 1:250K Series


Map Size

- Small
- Medium
- Large

View Scale

1 : 50,000

Update Map

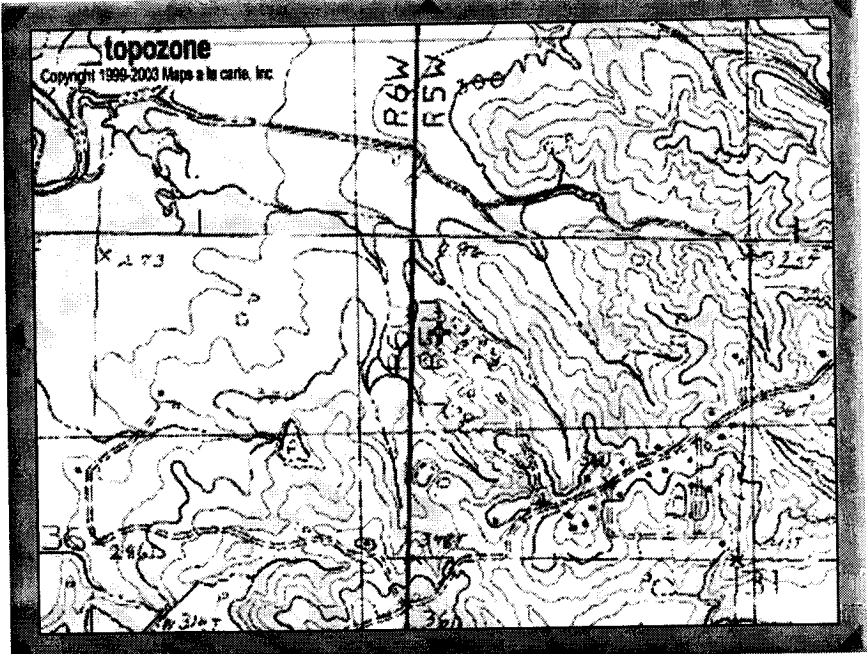

Coordinate Format

D/M/S

Coordinate Datum


WGS84/NAD83

Show target

Email this map

Bookmark this map

Print this map

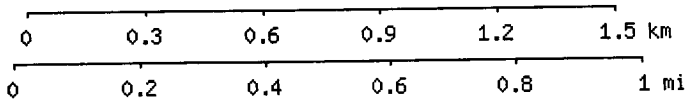

M=-0.17

G=-1.589

What's This?

mytopo.com

GET A CUSTOM MAP PRINT

TopoZone.com © 1999-2004 Maps a la carte, Inc. - All rights reserved.
 Use of this site is governed by our Conditions and Terms of Use. We care about your privacy - please read our Privacy Sta