State W	ell Report	For Office Use Only:		
	Driller's Log	Aquifer:		
Mississippi Departmer	Mississippi Department of Environmental Quality			
	and Water Resources Box 10631	Well #: <u>H-145</u>		
Driller the class Klassy	Jackson, MS 39289-0631			
	961-5210			
(601)35	4-6938 (fax)	E-log #:		
State Law requires that this report be prepared by the lic Department at the above address within 30 days of com	ense holder responsible for a polyton of drilling of the well	the work and filed with the or borehole.		
Information on Well Owner	Well or Bo	orehole Location		
(Landowner if borehole is not for a water well)	Latitude: 34 . 55, 89	Longitude: <u>89 •44 -122."</u>		
Owner Name Cortheal Wedden				
Mailing Address: LOT 34 Green Pasture cove	Method of Lat/Long (circle or	ne): Conventional Survey,		
Estates of Centerhill	NE-USGS quad, Hand-held			
	SE 1/ NW 1/2 Sec 9			
City State Zip Code	Distance Direction	Nearest Town		
	JUY Miles SE	Nearest Town of handy corner		
Telephone No. (<u>101) 428-8750</u>				
Well / Bor	ehole Data	.		
Date drilling started: $6 - 18 - 05$ Date drilling completed: $6 - 18 - 05$	Hole depth: 110'	Hole diameter: $63/4$		
Location of the source of any surface water used for drilling:	NA			
Location of the source of any surface water used for drilling:	elopment: <u>~</u> ?			
Logs run (circle all applicable): No log run Electric Gamma Ray Name of organization running log(s):				
Purpose of borehole (check one): Water Well Ceotechnical/Geo	logical Investigation Ground	d Source Heat Pump		
Seismic Survey Other (<i>describ</i> If drilling is not related to water well construction	e) on, skip the remainder of this b	lock		
Purpose of Well (check one): Home <i>V</i> Industrial Public Suppl	y Irrigation Fish Culture	Other:		
If a flowing well, method of flow regulation: Valve $\nearrow A$ Other (describe)				
Static Water Level: 10 feet above or felow (circle one) land surface Date measured: 7-14-05-				
Method of Measurement (circle one) steel tape electric tape air line other: String I weight				
Well depth: $\frac{110}{10}$ Well grouted to a depth of $\frac{10}{10}$ feet Typ				
Casing length: <u>90</u> feet Casing diameter: <u>4</u>				
Screen length: $\frac{\partial \heartsuit}{\partial \bigtriangledown}$ feet Screen diameter: $\frac{4}{2}$	inches Type of screen:	puc		
Screen slot size: <u>O10</u> inches Setting depth: From				
Type of completion (circle all applicable): Gravel packed Under	erreamed Telescoped Oper	n hole Natural Development		
Other (describe):				
Top of lap pipe or reduction in casing: $\sim \sim \wedge$ feet. If the feet of the feet	elescoped or more than one scr	<u>een, describe on next page</u>		
	·	Form: OLWR-SWR-1		

و.

BY, OLWR

4- 145


The sketch below only required for water wells

If well telescopes, show depths on sketch. Ground Level_

Description of formations encountered must be provided for all wells and boreholes, unless specifically exempted by regulations

Description of Formations Encountered	From (depth)	To (deptl
Clay dirt.	Ground Level	10
Clay dirt. while soud	10	110
		1
		1
· · · · · · · · · · · · · · · · · · ·		-
		+
COULD	· · · · · · · · · · · · · · · · · · ·	†
		<u> </u>
•••••••••••••••••••••••••••••••••••••••		
	+	<u> </u>

If more than one screen, show location of each on sketch

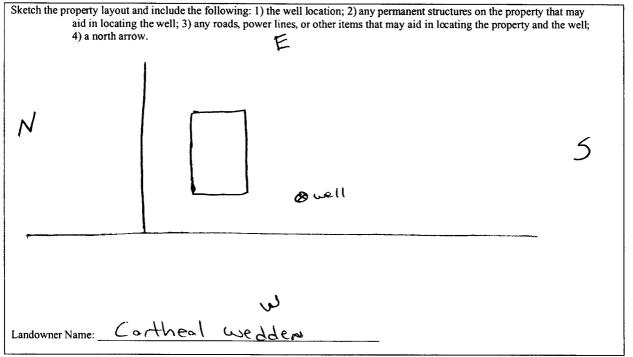

Form: OLWR-SWR-1A

I certify that the well/borehole was drilled, constructed, and completed in accordance with all applicable requirements of the Mississippi Department of Environmental Quality and the Mississippi Department of Health regulations, if applicable, and state
 laws.
 Jones W Messow
 0-620
 7-15-05
 Dars w. Mose

 Print Name of Responsible Licensee and License No.
 Date
 Signature of Licensee

BY OLMA

STATE W	ELL REPORT		
Permit #: Pump Installer Driller: Sovers Pick Driller: Sovers Pick Date completed: 7 - 14 -05 Jackson, (60)	Part 2 r's Completion Report ent of Environmental Quality and Water Resources Box 10631 MS 39289-0631 1)961-5210 554-6938 (fax) For Office Use Only: Aquifer: Well #: <u>H-145</u> Elevation:		
This part of the report must be completed by a licensed water well contractor or a licensed pump installer. A copy of Part 1 of the report must be attached and both parts filed with the Department at the above address within 30 days of well completion. Well Owner Information Well Location Owner Name: Cartheal Welden			
Mailing Address: LOT 34 Green Pasture cove Estate of Center Lill OLive Brown ms 38654 City State Zip Code Telephone No. (FOL) 428-8750	Method of Lat/Long (check one): Conventional Survey, USGS quad, Hand-held GPS, Survey-grade GPS $\underline{SE}_{14} \underline{N} \underline{\omega}_{14} \operatorname{Sec}_{9} \underline{T}_{2} \underline{S}_{R} \underline{5} \underline{\omega}$ Distance Direction Nearest Town $\underline{\partial'14}$ Miles \underline{SE}_{0} of $\underline{hc} \underline{nd}_{4}$ (or \underline{ne}		
Pump Type Circle one	Power Type Circle one		
Air LiftJetSubmersibleBucketPistonTurbineBucketPistonTurbineCentrifugalRotaryFlowing WellOther (specify):	Diesel Engine Gasoline Engine Natural Gas Electric Motor Hand Tractor PTO Windmill Other (specify):		
Pump Test Data Date Well Tested: $7 - 14 - 05$ Static Water Level (A): 10 Feet Below Land Surface Pumping Water Level (B): $3A$ Feet Below Land Surface Drawdown [(B) - (A)]: PA Feet Below Land Surface Test Pumping Rate: 18 Gallons Per Minute Duration of Pump Test (minimum 4 hours): 34 hours	Method of Measuring Water Level Circle oneAir LineElectric Measuring LineSteel TapeOther (specify): $String / weight$ For flowing well, measured shut in head: nA feetWell yielded18GPM with a drawdown of NA feet after18hours of pumping		

24 - K

I HEREBY CERTIFY that the above statements are true to the best of	f my knowledge.	
Jones W. Masu	Geno w. Marson	
Print Name of Pump Installer and License No. (if applicable)	Signature of Pump Installer	
	Form: OLWR-SWR-1	В

South from the start south of the start of t

RUSSEN BY OLWH