	State W	ell Report	E - Office Use Only		
Oss L	Part 1 – Driller's Log		For Office Use Only:		
County: Desoto-	Mississippi Department of Environmental Quality		Aquifer:		
Permit #:	Office of Land and Water Resources		Aquifer:		
Driller: Joves W. Moson.		ox 10631			
		S 39289-0631	L. S. Elevation:		
Date drilling completed: 8-33-05		961-5210	E-log#:		
	(601)354	4-6938 (fax)	E-log #.		
State Law requires that this repo	ort he prepared by the lice	ense holder responsible for	the work and filed with the		
Department at the above addres	s within 30 days of comp	letion of arilling of the well	or borenote.		
Information on Well	Owner	Well or Bo	brenote Location		
(Landowner if borehole is not	for a water well)	Latitude: 34 . 55 .08	1. Longitude: 89 • 45 · 328"		
Owner Name Forcest Will p	conerties-	Dutitudo	19		
		Method of Lat/Long (circle o	ne): Conventional Survey,		
Mailing Address: forest hill		USGS quad, Hand-held	d GPS, Survey-grade GPS		
Arbor da	e park-	SM 1/5 1/2 Sec 8	Twn OS Rng Sws Nearest Town of Miles		
		NW NW	7		
City Si	tate Zip Code	Distance Direction	Nearest Town		
		Miles	of <u>miller</u>		
Telephone No. (%1) 761 - 378	83				
	Well / Boro	ehole Data			
		2 135	Hala diameters 8 "		
Date drilling started: 8-33 Date					
Location of the source of any surface water used for drilling: Method of dosing and volume of Chlorine used in drilling and development:					
Logs run (circle all applicable): No log run Electric Gamma Ray Density Sonic Neutron Other:					
Name of organization ranning region.					
Purpose of borehole (check one): Water Well Geotechnical/Geological Investigation Ground Source Heat Pump					
Other (Jeserike)					
Seismic Survey Other (describe) If drilling is not related to water well construction, skip the remainder of this block					
Figh Culture Other					
Purpose of Well (check one): Home Industrial Public Supply Irrigation_ Fish Culture Other:					
If a flowing well, method of flow regulation: Valve Other (describe)					
Static Water Level:feet above of below (circle one) land surface Date measured: Static Water Level:					
Method of Measurement (circle one) steel tape electric tape air line other: 5tring / weight					
Well depth: 135 Well grouted to a depth of feet					
Casing length: 115 feet Casing diameter: 4 inches Type of casing:					
	Screen length: feet				
Screen slot size:inches					
Type of completion (circle all applicable): Gravel packed Underreamed Telescoped Open hole Natural Development					
Type of completion (circle all applicab	ie): (Gravei packed Ond	iorrealited relescoped op			

Top of lap pipe or reduction in casing:

Form: OLWR-SWR-1A

feet. If telescoped or more than one screen, describe on next page

RECEIVED
SEP 2 6 2835

BY: OLWR

The sketch	below onl	v required	for	water	wells


If	well	telesco	pes,	show	depths	on	sketch.

If i	well	telesco	opes,	show	depths	on	sketch
	Gro	ound L	evel		_		

Description of formations encountered must be provided for all wells and boreholes, unless specifically exempted by regulations

Description of Formations Encountered	From (depth)	To (depth)
clay dirt	Ground Level	
entitle said	33	39
while clay	39	45
white soul	45	28
white clay	85	E5
white sout	∂s=	135
	-	
		1
	L	

If more than one screen, show location of each on sketch

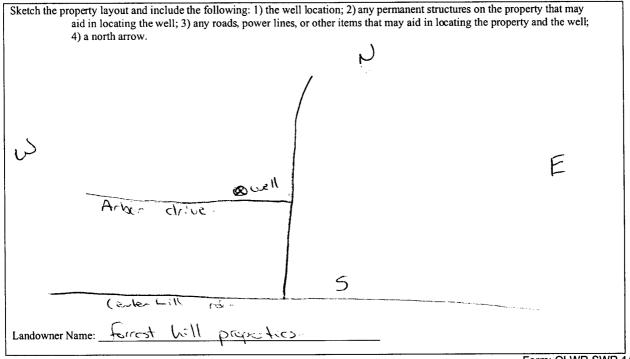

Form: OLWR-SWR-1A

I certify that the well/borehole was drilled, constructed, and completed in accordance with all applicable requirements of the Mississippi Department of Environmental Quality and the Mississippi Department of Health regulations, if applicable, and state

laws.		
<u> Joves</u>	L. Musica	C-63c
Print Name of	Responsible License	e and License No.

SEP 26 2005

BY: OLWR

STATE WELL REPORT

Permit #: Driller: Joses w. Mosson Date completed: 8-24-05 Copy information from block on Part 1

Part 2

Pump Installer's Completion Report
Mississippi Department of Environmental Quality
Office of Land and Water Resources
P.O. Box 10631
Jackson, MS 39289-0631
(601)961-5210

F	or Office Use Only:
	or other est only.
Aquifer:	
	114
Well #:	H-149
F1	
Elevatio	n:

Copy information from block on Part 1	(601)35	4-6938 (fax)	Elevation:	
	•	contractor or a licensed pump installer. A copy of Part 1 of the at the above address within 30 days of well completion.		
Well Owner Information			Location	
Owner Name: Forcest Will pr		Latitude: 34,55.08) Longitude: 89-45,322		
Mailing Address: torrest hill	subdiviseu	Method of Lat/Long (check one): Conventional Survey,		
Arbor drive	port.	USGS quad, Hand-held GPS, Survey-grade GPS		
City State	38654 Zip Code	50 1/2 Sw 1/2 Sec 8 T 25 R 500		
			Nearest Town	
Telephone No. (%) 761-3783		Miles E of	miller	
D T		n	ver Type	
Pump Type Circle one		1	rele one	
Air Lift Jet	Submersible	Diesel Engine Gasolin	e Engine Natural Gas	
Bucket Piston	Turbine (Electric Motor Hand	Tractor PTO	
Centrifugal Rotary	Flowing Well		specify):	
Other (specify):		Horse Power Rating of Motor: 712 4p-		
Date Pump Installed: 8-34-05		Setting Depth:feet		
Rated Pump Capacity:65	Gallons Per Minute	Number of Stages:	19	
Pump Test Data	6.	Method of Me	asuring Water Level	
Date Well Tested: 8- 34-05		Ci	rcle one	
		Air Line Electric Meas	suring Line Steel Tape	
Static Water Level (A):Feet Below Land Surface		Other (specify): String we rent		
Pumping Water Level (B): Peet	Below Land Surface	omer (specify).		
Drawdown [(B) – (A)]:Feet Below Land Surface		For flowing well, measured shut in head:feet		
Test Pumping Rate: 100 -	Gallons Per Minute	Well yielded GPM with a drawdown of		
Duration of Pump Test (minimum 4 hours):	hours	feet after	hours of pumping	

I HEREBY CERTIFY that the above statements are true to the best of my knowledge.

Print Name of Pump Installer and License No. (if applicable)

Signature of Pump Installer

Form: OLWR-SWR-1B/ ED