
Δ 1		Vell Report	For Office Use Only:
County: Desoto		Driller's Log nt of Environmental Quality	Aquifer:
Permit #:	Office of Land	and Water Resources	Well #: <u>H-152</u>
Driller: Jones w Moson		Box 10631 MS 39289-0631	L. S. Elevation:
Date drilling completed: 10-26-05	(601)961-5210	
······································	(601)35	54-6938 (fax)	E-log #:
State Law requires that this report			
Department at the above address Information on Well			rehole Location
(Landowner if borehole is not for a water well)		Latitude: 34 . 5 2 , 124" Longitude: 89. 44, 05	
Owner Name Coluin Jac	FRON	Latitude: <u>34 • 5 2 ' 124</u> " Longitude: <u>87 • 44</u> , 05 7 07	
Mailing Address: LOT 12 for	ruiew trails	Method of Lat/Long (circle or	
		USGS quad, Hand-held	GPS) Survey-grade GPS
\mathcal{P}		SE 4 NE 4 Sec 33	ک_{ے Reg} کری
<u>Byhalia Ms</u> City Sta	<u>کامی ا</u> ate Zip Code	USGS quad, Hand-held $\frac{5E}{2}$ $\frac{NE}{2}$ $\frac{NE}{2}$ Sec 33 Distance Direction $\frac{2}{2}$ Miles $\frac{NE}{2}$	Nearest Town
Telephone No. (101) 230- 68		<u> Miles</u> NE	of Stonewo Way ?
	Well / Bor	ehole Data	pi:0
Date drilling started: 10-76-05 Date dr	rilling completed: <u>10 - </u>	-05 Hole depth: 155'	Hole diameter: <u>8</u> `'
Location of the source of any surface wat	ter used for drilling: NA	t	
Method of dosing and volume of Chlorin	ne used in drilling and deve	elopment: مر	
Logs run (circle all applicable). No log ru Name of organization running log(s):	$\stackrel{\text{ID}}{\longrightarrow}$ Electric Gamma Ray	Density Sonic Neutron	Other:
Purpose of borehole (check one): Water W	Vell Geotechnical/Geo	logical Investigation Ground	Source Heat Pump
	SurveyOther (describ		
<u>If drilling is not related</u>	<u>d to water well construction</u>	on, skip the remainder of this bl	ock
	~		
Purpose of Well (check one): Home	Industrial Public Suppl		Other:
		yIrrigationFish Culture	
Purpose of Well (check one): Home	on: Valve NA	y Irrigation Fish Culture Dther (describe)	
Purpose of Well (check one): Home	on: Valve <u>NA</u> (bove of below (circle one)	y Irrigation Fish Culture Dther (describe) land surface Date measured:	
Purpose of Well (check one): Home	on: Valve <u>NA</u> bove of below (circle one) steel tape electric tape	yIrrigationFish Culture Other (describe) land surface Date measured: e air line other: <u></u>	10-26:05 -ing (weight
Purpose of Well (check one): Home	on: Valve NA (bove of below (brincle one) steel tape electric tape epth of 10 feet Typ	y Irrigation Fish Culture Dther (describe) land surface Date measured: e air line other: <u></u> e of grout (circle one): Neat Cen	10-26-05 Ting (weight Bentonite) Mix
Purpose of Well (check one): Home If a flowing well, method of flow regulated Static Water Level: feet a Method of Measurement (circle one) s Well depth: Well grouted to a d Casing length: feet Casing	on: Valve NA (bove of below (bircle one) steel tape electric tape epth of <u>10</u> feet Typ ing diameter: <u>4</u>	y Irrigation Fish Culture Dther (describe) land surface Date measured: air line other: <u>Str</u> e of grout (circle one): Neat Cen inches Type of casing:	10-26:05 Ting Iweight Bentonite Mix puc
Purpose of Well (check one): Home	on: Valve NA (bove of below (circle one) steel tape electric tape epth of <u>10</u> feet Typ ing diameter: <u>4</u>	yIrrigationFish Culture Dther (describe) land surface Date measured: air line other: <u></u> e of grout (circle one): Neat Cen inches Type of casing: inches Type of screen:	10-26.05 ing Iweight nent Bentonite Mix puc
Purpose of Well (check one): Home If a flowing well, method of flow regulated Static Water Level:	on: Valve <u>NA</u> bove of below (circle one) steel tape electric tape epth of <u>10</u> feet Typ ing diameter: <u>4</u> cen diameter: <u>4</u> Setting depth: From _	yIrrigationFish Culture Dther (describe) land surface Date measured: e air line other: <u></u> e of grout (circle one): Neat Cen inches Type of casing: inches Type of screen: feet to	10-26.05 ing Iweight ment Bentonite Mix puc puc 155 feet

Top of lap pipe or reduction in casing: <u>NA</u>. feet. <u>If telescoped or more than one screen, describe on next page</u>

Form: OLWR-SWR-1A

H-152

Description of formations encountered must be provided for all The sketch below only required for water wells wells and boreholes, unless specifically exempted by regulations If well telescopes, show depths on sketch. To (depth) Description of Formations Encountered From (depth) Ground Level. dirt Ground Level 30 Clark 45 30 45 <u>78</u> 80 c \mathcal{R} Son 155 RECEIVED If more than one screen, show location of each on sketch

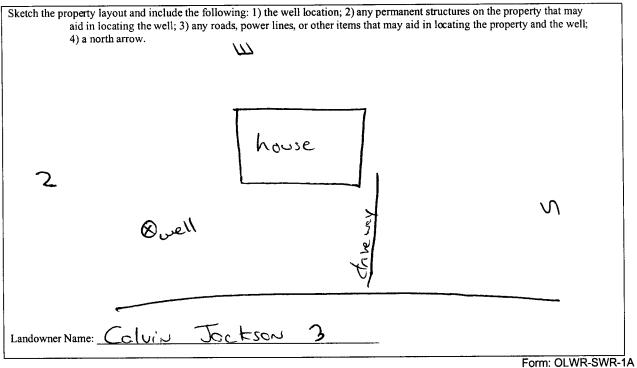

I certify that the well/borehole was drilled, constructed, and completed in accordance with all applicable requirements of the Mississippi Department of Environmental Quality and the Mississippi Department of Health regulations, if applicable, and state

Date

laws. Wason 0-620 11-22-05 omes

Signature of Licensee

Print Name of Responsible Licensee and License No.

ž

County: Oesoto Part	,
Pump Installer's Con	For Office Use Only:
Permit #: Mississippi Department of E Office of Land and W	
Driller: Jones W. Masen P.O. Box 1	L_{150}
Date completed: 10 - 36.05 Jackson, MS 39 (601)961-5 (601)961-5	210
Copy information from block on Part 1 (601)354-693	8 (fax)

۰.

Г

 This part of the report must be completed by a licensed water well contractor or a licensed pump installer. A copy of Part 1 of the report must be attached and both parts filed with the Department at the above address within 30 days of well completion.

 Well Owner Information
 Well Location

l			
	Owner Name: Coluin Jackson	Latitude: <u>34, 52, 124</u> Longitude: <u>89, 44, 052</u>	
	Mailing Address: LOT 12	Method of Lat/Long (check one): Conventional Survey,	
	foirvieus Troils	USGS quad, Hand-held GPS_, Survey-grade GPS	
	Byholic MS 38611 City State Zip Code	<u>JE 1/ NE 1/2 Sec 33 T 25 R 500</u>	
	City State Zip Code	Distance Direction Nearest Town RECEIV	Fr
	Telephone No. (901) $\partial 30 - 6 \partial 15$	<u>A Miles NE of Stanewoll NOV 28 20</u>	<u>с</u> 05
1			
	Pump Type Circle one	Power Type Circle one BY: OLV	/R
	Air Lift Jet Submersible	Diesel Engine Gasoline Engine Natural Gas	
	Bucket Piston Turbine	Electric Motor Hand Tractor PTO	
	Centrifugal Rotary Flowing Well	Windmill Other (specify):	
	Other (specify):	Horse Power Rating of Motor:	
	Date Pump Installed: 10-36-05	Setting Depth: [10'feet	
and a second sec	Rated Pump Capacity: (J Gallons Per Minute	Number of Stages: ((
	Pump Test Data	Method of Measuring Water Level	
	•	Circle one	

	Circle one
Date Well Tested: $10 - 36 - 07$	Air Line Electric Measuring Line Steel Tape
Static Water Level (A):Feet Below Land Surface	Other (specify): String (weight
Pumping Water Level (B):Feet Below Land Surface	<u> </u>
Drawdown [(B) – (A)]: $\mathcal{N}^{\mathcal{A}}$ Feet Below Land Surface	For flowing well, measured shut in head: $\underline{\mathcal{NA}}$ feet
Test Pumping Rate: Gallons Per Minute	Well yielded [2GPM with a drawdown of
Duration of Pump Test (minimum 4 hours): <u>Ə</u> . hours	$_$ \checkmark \land feet after $_$ $\xrightarrow{\partial 4}$ hours of pumping

I HEREBY CERTIFY that the above statements are true to the best	of my knowledge.
Jones W. Marcu	Jarow. Marzy
Print Name of Pump Installer and License No. (if applicable)	Signature of Pump Installer
	Earm: OLIMP SMP 1P

Form: OLWR-SWR-1B

٦