

County: Desoto  
 Permit #: \_\_\_\_\_  
 Driller: Jones W. Masor  
 Date drilling completed: 12-21-05

**State Well Report**  
**Part 1 - Driller's Log**

Mississippi Department of Environmental Quality  
 Office of Land and Water Resources  
 P.O. Box 10631  
 Jackson, MS 39289-0631  
 (601)961-5210  
 (601)354-6938 (fax)

**For Office Use Only:**  
 Aquifer: \_\_\_\_\_  
 Well #: H-158  
 L. S. Elevation: \_\_\_\_\_  
 E-log #: \_\_\_\_\_

*State Law requires that this report be prepared by the license holder responsible for the work and filed with the Department at the above address within 30 days of completion of drilling of the well or borehole.*

Information on Well Owner (Landowner if borehole is not for a water well)	Well or Borehole Location
Owner Name: <u>Chad Parks</u>	Latitude: <u>34.56.093</u> Longitude: <u>89.47.003</u>
Mailing Address: <u>Chappell Cove</u>	Method of Lat/Long (circle one): <u>Hand-held GPS</u>
<u>LOT 5</u>	USGS quad, <u>Hand-held GPS</u> , Survey-grade GPS
<u>Oliver Brown ms 38654</u>	NW <u>1</u> SE <u>1</u> Sec <u>1</u> Twn <u>25</u> Rng <u>6W</u>
City State Zip Code	Distance Direction Nearest Town
Telephone No. <u>901,921-8166</u>	<u>12</u> Miles <u>NE</u> of <u>Fairhaven</u>

**Well / Borehole Data**

Date drilling started: 12-21-05 Date drilling completed: 12-21-05 Hole depth: 240' Hole diameter: 8"

Location of the source of any surface water used for drilling: NA

Method of dosing and volume of Chlorine used in drilling and development: NA

Logs run (circle all applicable): No log run Electric Gamma Ray Density Sonic Neutron Other: \_\_\_\_\_

Name of organization running log(s): \_\_\_\_\_

Purpose of borehole (check one): Water Well  Geotechnical/Geological Investigation \_\_\_\_\_ Ground Source Heat Pump \_\_\_\_\_

Seismic Survey \_\_\_\_\_ Other (describe) \_\_\_\_\_

*If drilling is not related to water well construction, skip the remainder of this block*

Purpose of Well (check one): Home  Industrial \_\_\_\_\_ Public Supply \_\_\_\_\_ Irrigation \_\_\_\_\_ Fish Culture \_\_\_\_\_ Other: \_\_\_\_\_

If a flowing well, method of flow regulation: Valve NA Other (describe) \_\_\_\_\_

Static Water Level: 122 feet above or below (circle one) land surface Date measured: 1-4-07

Method of Measurement (circle one) steel tape electric tape air line other: String Weight

Well depth: 240 Well grouted to a depth of 10 feet Type of grout (circle one): Neat Cement Bentonite Mix

Casing length: 220 feet Casing diameter: 4 inches Type of casing: pvc

Screen length: 20 feet Screen diameter: 4 inches Type of screen: pvc

Screen slot size: .010 inches Setting depth: From 220 feet to 240 feet

Type of completion (circle all applicable): Gravel packed Underreamed Telescoped Open hole Natural Development

Other (describe): NA

Top of lap pipe or reduction in casing: NA feet. *If telescoped or more than one screen, describe on next page*

Form: OLWR-SWR-1A


RECEIVED  
 JAN 20 2006  
 BY: OLWR

H-158

The sketch below only required for water wells

Description of formations encountered must be provided for all wells and boreholes, unless specifically exempted by regulations


If well telescopes, show depths on sketch

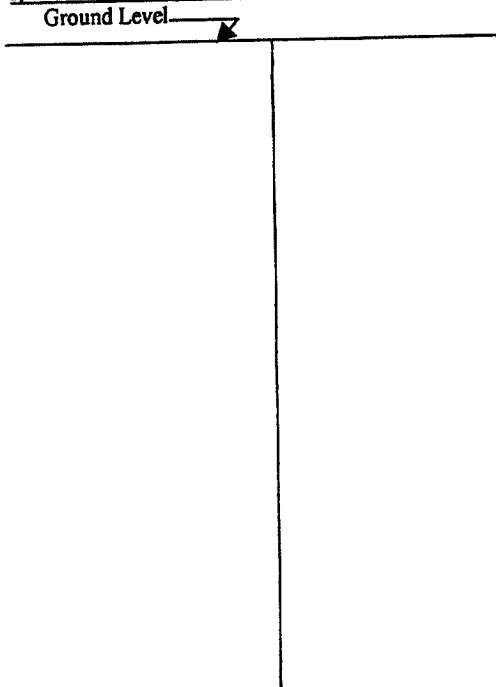

Description of Formations Encountered	From (depth)	To (depth)
Clay dirt	Ground Level	10
Gravel	10	50
Red sand	50	60
white clay	60	100
Blue clay	100	120
white sand	120	140
Blue clay	140	170
white sand	170	240

If more than one screen, show location of each on sketch

Sketch the property layout and include the following: 1) the well location; 2) any permanent structures on the property that may aid in locating the well; 3) any roads, power lines, or other items that may aid in locating the property and the well; 4) a north arrow.

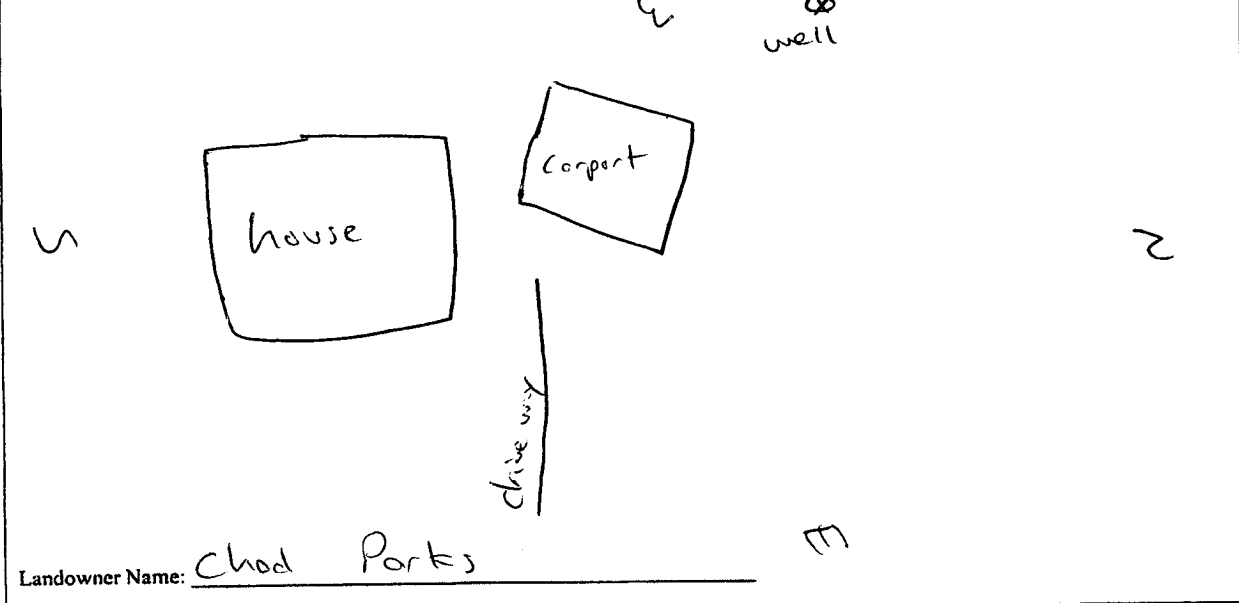

Form: OLWR-SWR-1A

I certify that the well/borehole was drilled, constructed, and completed in accordance with all applicable requirements of the Mississippi Department of Environmental Quality and the Mississippi Department of Health regulations, if applicable, and state laws.

Jones W. Maser 0-620 1-16-06  
Print Name of Responsible Licensee and License No. Date

[Signature]  
Signature of Licensee

RECEIVED  
JAN 20 2006  
BY: OLWR

# STATE WELL REPORT

## Part 2

**Pump Installer's Completion Report**  
 Mississippi Department of Environmental Quality  
 Office of Land and Water Resources  
 P.O. Box 10631  
 Jackson, MS 39289-0631  
 (601)961-5210  
 (601)354-6938 (fax)

County: Desoto  
 Permit #: \_\_\_\_\_  
 Driller: Jones w. Mason  
 Date completed: 1-4-06  
*Copy information from block on Part 1*

**For Office Use Only:**

Aquifer: \_\_\_\_\_  
 Well #: H-158  
 Elevation: \_\_\_\_\_

*This part of the report must be completed by a licensed water well contractor or a licensed pump installer. A copy of Part 1 of the report must be attached and both parts filed with the Department at the above address within 30 days of well completion.*

Well Owner Information	Well Location
Owner Name: <u>Chad Parks</u>	Latitude: <u>34.56-093</u> Longitude: <u>89.47-003</u> <span style="margin-left: 100px;"><u>05</u></span> <span style="margin-left: 100px;"><u>00</u></span>
Mailing Address: <u>LOT 5</u> <u>Chappell Cove</u> <u>Olive Branch MS 38654</u> City State Zip Code	Method of Lat/Long (check one): Conventional Survey _____ USGS quad _____, Hand-held GPS <input checked="" type="checkbox"/> , Survey-grade GPS _____ <u>NW 1/4 SE 1/4 Sec 1 T2S R6W</u>
Telephone No. <u>901 921-8166</u>	Distance Direction Nearest Town <u>1/2</u> Miles <u>NE</u> of <u>Fairhaven</u>

Pump Type Circle one	Power Type Circle one
Air Lift Jet <input type="checkbox"/> <u>Submersible</u>	Diesel Engine Gasoline Engine Natural Gas
Bucket Piston <input type="checkbox"/> Turbine <input type="checkbox"/>	<u>Electric Motor</u> Hand <input type="checkbox"/> Tractor PTO <input type="checkbox"/>
Centrifugal Rotary <input type="checkbox"/> Flowing Well <input type="checkbox"/>	Windmill Other (specify): _____
Other (specify): _____	Horse Power Rating of Motor: <u>2 Hp.</u>
Date Pump Installed: <u>1-4-06</u>	Setting Depth: <u>160</u> feet
Rated Pump Capacity: <u>25</u> Gallons Per Minute	Number of Stages: <u>14</u>

Pump Test Data	Method of Measuring Water Level Circle one
Date Well Tested: <u>1-4-06</u>	Air Line Electric Measuring Line Steel Tape
Static Water Level (A): <u>122</u> Feet Below Land Surface	Other (specify): <u>string weight</u>
Pumping Water Level (B): <u>NA</u> Feet Below Land Surface	For flowing well, measured shut in head: <u>NA</u> feet
Drawdown [(B) - (A)]: <u>NA</u> Feet Below Land Surface	Well yielded <u>25</u> GPM with a drawdown of
Test Pumping Rate: <u>25</u> Gallons Per Minute	<u>NA</u> feet after <u>24</u> hours of pumping
Duration of Pump Test (minimum 4 hours): <u>24</u> hours	

I HEREBY CERTIFY that the above statements are true to the best of my knowledge.

Jones w. Mason \_\_\_\_\_  
 Print Name of Pump Installer and License No. (if applicable) Signature of Pump Installer

Form: OLWR-SWR-1B

RECEIVED

JAN 20 2006

BY: OLWR