County: Desoto	1	/ell Report Driller's Log	For Office Use Only
Permit #: Driller: Jones W. MaSon Date drilling completed: 1-14-06	Mississippi Departmen Office of Land a P.O. I Jackson, M (601)	and Water Resources Box 10631 AS 39289-0631 0961-5210 4-6938 (fax)	Aquifer: Well #: L. S. Elevation: E-log #:
State Law requires that this repo <u>Department</u> at the above address Information on Well (Landowner if borehole is not f Owner Name Oeo Corpo Mailing Address: ILS red B	s within 30 days of comp Owner For a water well) evfer	Latitude: 34 • 51 • 766 Method of Lat/Long (circle or	or borehole. rehole Location " Longitude: <u>89 ° 45</u> , 4 e): Conventional Survey,
	5 <u>3861</u> ate Zip Code	USGS quad, Hand-held SE 1/25E 1/2 Sec_31	GP3, Survey-grade GPS Twn <u>25</u> Rng <u>5</u>

-

Telephone No. $(901) 5 30 - 1673$				
Well / Borehole Data 210'				
Date drilling started: $1 - 1 - 4$ Date drilling completed! $-1 - 4 - 6$ Hole depth: 4 Hole diameter: $8'$				
Location of the source of any surface water used for drilling: $\ \ \ \ \ \ \ \ \ \ \ \ \ \ \ \ \ \ \$				
Logs run (circle all applicable) No log run Electric Gamma Ray Density Sonic Neutron Other:				
Purpose of borehole (check one): Water WellGeotechnical/Geological Investigation Ground Source Heat Pump				
Seismic SurveyOther (describe) If drilling is not related to water well construction, skip the remainder of this block				
Purpose of Well (check one): Home 2 Industrial Public Supply Irrigation Fish Culture Other:				
If a flowing well, method of flow regulation: Valve $\hgar{2}{24}$ Other (describe)				
Static Water Level: <u>92</u> feet above on below (circle one) land surface Date measured: <u>$1-19-06$</u>				
Method of Measurement (circle one) steel tape electric tape air line other: String (weight				
Well depth: $\frac{\partial(0)}{\partial t}$ Well grouted to a depth of <u>lo</u> feet Type of grout (circle one): Neat Cement Bentonite Mix				
Casing length: <u>190</u> feet Casing diameter: <u>4</u> inches Type of casing: <u>psc</u>				
Screen length: $\underline{\partial} \underline{\partial}$ feet Screen diameter: $\underline{4}$ inches Type of screen: $\underline{\rho} \underline{\vee} \underline{C}$				
Screen slot size: 010 inches Setting depth: From 190 feet to 210 , feet				
Type of completion (circle all applicable) Gravel packed Underreamed Telescoped Open hole Natural Development				
Other (describe):				
Top of lap pipe or reduction in casing: feet. If telescoped or more than one screen, describe on next page				
Form: OLWR-SWR-1A				

FEB 1 5 2006 BY: OLWR

H- 159


The sketch below only required for water wells

If well telescopes, show depths on sketch. Ground Level

Description of formations encountered must be provided for all wells and boreholes, unless specifically exempted by regulations

Description of Formations Encountered	From (depth)	To (depth)
clay dirt.	Ground Level	5
gravel	S	65
white sched	65	90
white clay	୧୦	110
while souch	(10	(30
white clay	130	170
white five send	(70	210
	1	1
		1
	1	J

If more than one screen, show location of each on sketch

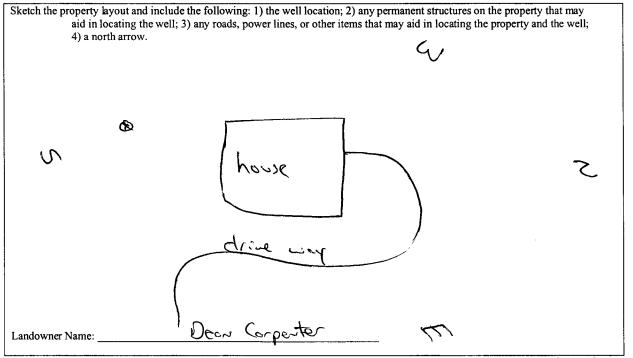

Form: OLWR-SWR-1A

I certify that the well/borehole was drilled, constructed, and completed in accordance with all applicable requirements of the Mississippi Department of Environmental Quality and the Mississippi Department of Health regulations, if applicable, and state

2-14-06

laws. Jone w. Masar 0-620

Genow Man-

Print Name of Responsible Licensee and License No.

. Date

Signature of Licensee

RECEIVED FEB 1 5 2006 BY: OLWR

STATE WELL REPORT				
County: Desoto	Part 2 Pump Installer's Completion Report	For Office Use Only:		
Permit #:	Mississippi Department of Environmental Quality	Aquifer:		
Driller: Jones w. Mason	Office of Land and Water Resources P.O. Box 10631	11 150		
Date completed: $1 - 19 - 0$	Jackson, MS 39289-0631 (601)961-5210	Well #: <u>#-159</u>		
Copy information from block on Part 1	(601)354-6938 (fax)	Elevation:		

This part of the report must be completed by a licensed water well contractor or a licensed pump installer. A copy of Part 1 of the report must be attached and both parts filed with the Department at the above address within 30 days of well completion.

well Owner Information	well Location
Owner Name: Dean Corperter Mailing Address: 165 red books rd	Latitude: <u>34, 51, 766</u> Longitude: <u>89, 45, 650</u> 46 Method of Lat/Long (check one): Conventional Survey,
Byhalia MS 3861/ City State Zip Code	USGS quad, Hand-held GPS \checkmark , Survey-grade GPS <u>SE 14 SE</u> 14 Sec <u>31</u> T <u>S</u> R <u>5</u> ω
Telephone No. (901) 550 -1673	Distance Direction Nearest Town 1/16 Miles N of Stonewoll

Pump Type Circle one		Power Type Circle one			
Air Lift	Jet	Submersible	Diesel Engine	Gasoline Engine	Natural Gas
Bucket	Piston	Turbine	Electric Motor	Hand	Tractor PTO
Centrifugal	Rotary	Flowing Well	Windmill	Other (specify):	
Other (specify):		·····	Horse Power Ratin	g of Motor: $3/4$	
Date Pump Installed:	1-19-0	200	Setting Depth:	140	feet
Rated Pump Capacity	. 12	Gallons Per Minute	Number of Stages:	(/	

Pump Test Data	Method of Measuring Water Level
Date Well Tested: 1-19-06	Circle one
Static Water Level (A): 92 Feet Below Land Surface	Air Line Electric Measuring Line Steel Tape
Static Water Level (A):Feet Below Land Surface	Other (specify): String (neight
Pumping Water Level (B): <u> PA</u> Feet Below Land Surface	
Drawdown [(B) – (A)]:Feet Below Land Surface	For flowing well, measured shut in head: feet
Test Pumping Rate: (2 Gallons Per Minute	Well yielded GPM with a drawdown of
Duration of Pump Test (minimum 4 hours): $\underline{\partial 4}$ hours	$\underline{\mathcal{M}}_{\text{feet after}} \xrightarrow{\partial \mathcal{H}}_{\text{hours of pumping}}$

I HEREBY CERTIFY that the above statements are true to the best	t of my <u>kn</u> owledge.	
Jones w. Mason	Gan w. Man.	
Print Name of Pump Installer and License No. (if applicable)	Signature of Pump Installer	
	Form: OLWR-SWR-1B	
	RECEIVI	ED

FEB 1 5 2006 BY: OLWR