State W	State Well Report			
	Driller's Log			
	t of Environmental Quality Aquifer:			
Permit #: Office of Land a	well #: H-167			
Driller NAPY (SL/VIASCO)	Sox 10051			
Jackson, N	1S 39289-0631 L. S. Elevation: 961-5210			
	4-6938 (fax) E-log #:			
State Law requires that this report be prepared by the license holder responsible for the work and filed with the Department at the above address within 30 days of completion of drilling of the well or borehole.				
Information on Well Owner	Well or Borehole Location			
(Landowner if borehole is not for a water well)	Latinda 34.55 , Dor" Langituda 89. 44. 126.			
Owner Name Tonisha Jelks	Latitude: <u>34°55</u> , <u>887</u> " Longitude: <u>89°44</u> , <u>124</u> " <u>48</u> Method of Lat/Long (circle one): Conventional Survey,			
Mailing Address: 4751 Estates of centerhill	LISCS awad Hand hald CDY Survey grade CDS			
	SE 1/2 NC 1/2 Sec_ 9 VTwn_ 2 5 VRng 5 W			
Olive Brown Ms 38654 City State Zip Code	NC NC			
	Distance Direction Nearest Town <u>Direction</u> SE of handy curver			
Telephone No. (901) 485 - 3348				
Well / Bore	hole Data			
Date drilling started: $5 - 13 - 96$ Date drilling completed: $5 - 13 - 96$ Hole depth: 85 Hole diameter: $8'$				
Location of the source of any surface water used for drilling:				
Logs run (circle all applicable): No log run Electric Gamma Ray Density Sonic Neutron Other:				
Purpose of borehole (check one): Water Well <u>Geotechnical/Geological Investigation</u> Ground Source Heat Pump				
Seismic SurveyOther (<i>describe</i>				
If drilling is not related to water well construction				
Purpose of Well (check one): Home 🖌 Industrial Public Supply Irrigation Fish Culture Other:				
If a flowing well, method of flow regulation: Valve \sim C	Other (describe)			
Static Water Level:feet above α below (circle one) land surface Date measured: $5 - 13 - 06$				
Method of Measurement (circle one) steel tape electric tape air line other: <u>Strivs (weight</u>				
Well depth: 85 Well grouted to a depth of 10 feet Type of grout (circle one): Neat Cement Bentonity Mix				
Casing length: <u>65</u> feet Casing diameter: <u>4</u> inches Type of casing: <u>puc</u>				
Screen length: $\frac{\partial \circ}{\partial c}$ feet Screen diameter: $\frac{d}{\partial c}$ inches Type of screen: $\frac{\partial \circ}{\partial c}$				
Screen slot size: 010 inches Setting depth: From <u>65</u> feet to <u>85</u> feet				
Type of completion (circle all applicable): Gravel packed Underreamed Telescoped Open hole Natural Development				
Other (describe):A				
Top of lap pipe or reduction in casing:feet. If telescoped or more than one screen, describe on next page				

· ,

Form: OLWR-SWR-1A

JUN 1 2 2006 BY: OLWR

14-161


The sketch below only required for water wells

If well telescopes, show depths on sketch. Ground Level____

<u>v uepins on skeich</u>	Description of Formations Encountered	From (depth)	To (depth)
K	clay dirt	Ground Level	12
· · ·	white clay	12	30
	white soud	30	85
		-	
	Annual State Television		
			1
			1
			1

Description of formations encountered must be provided for all wells and boreholes, unless specifically exempted by regulations

If more than one screen, show location of each on sketch

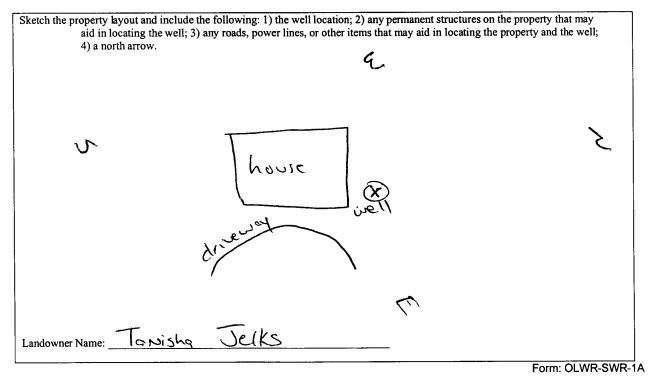

I certify that the well/borehole was drilled, constructed, and completed in accordance with all applicable requirements of the Mississippi Department of Environmental Quality and the Mississippi Department of Health regulations, if applicable, and state laws.

The w-Meson 0-670 6-8-06 Print Name of Responsible Licensee and License No. Date

Jono un Signature of Licensee

RECEIVED JUN 1 2 2006 BY: OLWR

STATE WELL REPORT			
County: <u>Desoto</u> Permit #: Driller: <u>Jones</u> <u>Masa</u> Date completed: <u>S-13-06</u>	Part 2 Pump Installer's Completion Report Mississippi Department of Environmental Quality Office of Land and Water Resources P.O. Box 10631 Jackson, MS 39289-0631	For Office Use Only: Aquifer: Well #: <u>H - 160</u>	
Copy information from block on Part 1		961-5210 4-6938 (fax)	Elevation:
This part of the report must be completed by a licensed water well contractor or a licensed pump installer. A copy of Part 1 of the report must be attached and both parts filed with the Department at the above address within 30 days of well completion.			
Well Owner Informa	ation	We	ell Location

Owner Name: Tenisha Jeiks Mailing Address: 4757 Estates of center hill Ouve Brock Mis 38654 City State Zip Code Telephone No. (94) 485-3348	Latitude: $34.55.807$ Longitude: $87.44.126$ Method of Lat/Long (check one): Conventional Survey, USGS quad, Hand-held GPS \checkmark , Survey-grade GPS $SE_{4}NV_{4}Sec_{7}T_{2}S_{8}Sw_$ Distance Direction Nearest Town 314 Miles SE_{6} of $4cordy_{7}Cvrwer$
Pump Type	Power Type
Circle one	Circle one
Air Lift Jet Submersible	Diesel Engine Gasoline Engine Natural Gas
Bucket Piston Turbine	Electric Motor Hand Tractor PTO
Centrifugal Rotary Flowing Well	Windmill Other (specify):
Other (specify):	Horse Power Rating of Motor:
Date Pump Installed: 5-13-06	Setting Depth:feet
Rated Pump Capacity:Gallons Per Minute	Number of Stages: 14
Pump Test Data Date Well Tested: <u>S- (3-06</u>	Method of Measuring Water Level Circle one
Static Water Level (A): \bigcirc I Feet Below Land Surface Pumping Water Level (B): $\overset{\checkmark}{\overset{\checkmark}{}}$ Feet Below Land Surface	Air Line Electric Measuring Line Steel Tape Other (specify): <u>String</u> (weight
Drawdown [(B) – (A)]: <u>NA</u> Feet Below Land Surface Test Pumping Rate: <u>20</u> Gallons Per Minute	For flowing well, measured shut in head: $$ feet Well yielded $$ O GPM with a drawdown of

I HEREBY CERTIFY that the above statements are true to the best of	of my knowledge.
Jones J. Mason	Jans w. Maran.
Print Name of Pump Installer and License No. (if applicable)	signature of Pump Installer

_hours

NA

JUN 1 2 2006 BY: OLWR

_hours of pumping

24

_feet after