	State Well Report	
		For Office Use Only:
County: Desate	Part 1 – Driller's Log	
	Mississippi Department of Environmental Quality	Aquifer:
Permit #:	Office of Land and Water Resources	Well #: H-174
Driller: Jones W. Moson	P.O. Box 10631	Well #:
Dimer. Open 00 11 casor	Jackson, MS 39289-0631	L. S. Elevation:
Date drilling completed: 8-2-06	(601)961-5210	
	(601)354-6938 (fax)	E-log #:

۲

3

State Law requires that this report be prepared by the license holder responsible for the work and filed with the Department at the above address within 30 days of completion of drilling of the well or borehole.

Information on Well Owner	Well or Borehole Location	
(Landowner if borehole is not for a water well)		
Owner Name K-C Builders	Latitude: <u>34° 53</u> , 115 " Longitude: <u>89° 44</u> , 065" 07 04	
Mailing Address: LOT	Method of Lat/Long (circle one): Conventional Survey,	
fairvious trails	USGS quad, Hand-held GPS, Survey-grade GPS	
_	SE 4 NE 4 Sec 33 Twn 25 Rng Sw	
Bybelia MS 38611 City State Zip Code	Distance Direction Nearest Town <u>112</u> Miles NE of Streewell	
Telephone No. (66).) 870 ~ 5639	Miles NE of Streubl	
Well / Bore	hole Data	
Date drilling started: $\frac{\vartheta}{\vartheta} - \frac{\vartheta}{\vartheta}$ Date drilling completed: $\frac{\vartheta}{\vartheta} - \frac{\vartheta}{\vartheta} - \frac{\vartheta}{\vartheta}$	\bigcirc Hole depth: $l 55'$ Hole diameter: $\bigcirc 314''$	
Location of the source of any surface water used for drilling: $\underline{\mathcal{M}}$. Method of dosing and volume of Chlorine used in drilling and devel	A- opment:	
Logs run (circle all applicable): No log rup Electric Gamma Ray Density Sonic Neutron Other:		
Purpose of borehole (check one): Water Well 🖌 Geotechnical/Geol	ogical Investigation Ground Source Heat Pump	
Seismic Survey Other (describe)		
Purpose of Well (check one): Home / Industrial Public Supply Irrigation Fish Culture Other:		
If a flowing well, method of flow regulation: Valve $ \sim$ \sim \sim	ther (describe)	
Static Water Level: 60 feet above or below (circle one) land surface Date measured: 8-3-06		
Method of Measurement (circle one) steel tape electric tape air line other: String (weight		
Well depth: 155 Well grouted to a depth of 10 feet Type of grout (circle one): Neat Cement Bentonite Mix		
Casing length: <u>145</u> feet Casing diameter: <u>4</u> inches Type of casing: <u>pet</u>		
Screen length: <u>10</u> feet Screen diameter: <u>4</u> inches Type of screen: <u>put</u>		
Screen slot size:		
Type of completion (circle all applicable). Gravel packed Underreamed Telescoped Open hole Natural Development		
Other (describe):		
Top of lap pipe or reduction in casing: <u>MA</u> feet. <u>If te</u>	lescoped or more than one screen, describe on next page	
L,	Farming Wites With In	


AUG 3 1 2006 BY: OLWA

H- 174


The sketch below only required for water wells

If well telescopes, show depths on sketch. Ground Level

ъ

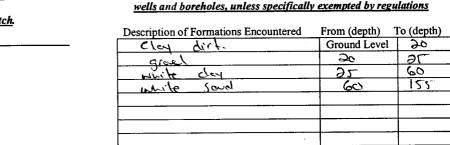

Description of formations encountered must be provided for all

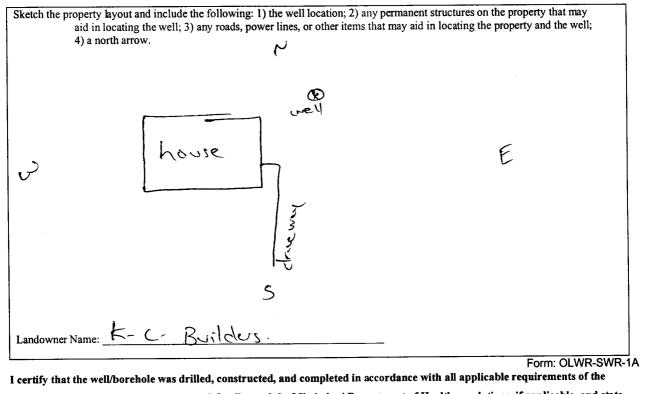

Mississippi Department of Environmental Quality and the Mississippi Department of Health regulations, if applicable, and state

Date

w. Moyon 0-620 8-27-06 Jores

fors w. N AUG 3 1 2006 Signature of Licensee BY OLWR

Print Name of Responsible Licensee and License No.

	STATE WELL REPORT	
County: Desoto	Part 2 Pump Installer's Completion Report	For Office Use Only:
Permit #:	Mississippi Department of Environmental Quality Office of Land and Water Resources	Aquifer:
Driller: Jones us. Moson	P.O. Box 10631	Well #: H-174
Date completed: 2-3-06	Jackson, MS 39289-0631 (601)961-5210	Elevation:
Copy information from block on Part 1	(601)354-6938 (fax)	

.

.

 This part of the report must be completed by a licensed water well contractor or a licensed pump installer. A copy of Part 1 of the report must be attached and both parts filed with the Department at the above address within 30 days of well completion.

 Well Owner Information
 Well Location

wen Owner Information	W Ch Location
Owner Name: K-C-Builders	Latitude: 34.52,115 Longitude: 89,44,065
Mailing Address: LOT 9	Method of Lat/Long (check one): Conventional Survey,
toirview trails	USGS quad, Hand-held GPS, Survey-grade GPS
Byholia MS 38611 City State Zip Code	SE 4 NE 4 Sec 33 T 25 R SW
City State Zip Code	Distance Direction Nearest Town
Telephone No. (66) 890 - 5629	142 Miles NE of Stonewall

	Pump Type Circle one			Power Type Circle one	
Air Lift	Jet	Submersible	Diescl Engine	Gasoline Engine	Natural Gas
Bucket	Piston	Turbine	Electric Motor	Hand	Tractor PTO
Centrifugal	Rotary	Flowing Well	Windmill	Other (specify):	
Other (specify):			Horse Power Rating	of Motor: 3/4	· · · · · · · · · · · · · · · ·
Date Pump Installed: _	8-3-06		Setting Depth:	100	_feet
Rated Pump Capacity:	12	Gallons Per Minute	Number of Stages:		_

Pump Test Data	Method of Measuring Water Level Circle one	
Date Well Tested: 8-3-06	Air Line Electric Measuring Line Steel Tape	
Static Water Level (A): <u>60</u> Feet Below Land Surface	Other (specify): String (weight	
Pumping Water Level (B):Feet Below Land Surface		
Drawdown [(B) – (A)]:Feet Below Land Surface	For flowing well, measured shut in head:feet	
Test Pumping Rate: Gallons Per Minute	Well yielded GPM with a drawdown of	
Duration of Pump Test (minimum 4 hours): u[hours	hours of pumping	

I HEREBY CERTIFY that the above statements are true to the best of	my knowledge .	
Print Name of Pump Installer and License No. (if applicable)	Signature of Pump Installer	-RECEIVED
Print Name of Pump instance and License No. (if applicable)	Spharato of Yang Instance	Form: OLWR-SWR-1B
		BY: OLWE