County: $0 \in 5 \in 40$ Part 1 - IPermit #:Mississippi DepartmentPermit #:Office of Land aDriller: $5 = 0 = 0$ Driller: $5 = 0 = 0$ Date drilling completed: $9 = 16 = 06$ (601)	pletion of drilling of the well	or borehole.		
Information on Well Owner (Landowner if borehole is not for a water well)		Prehole Location		
Owner Name K-C-Builders.	Method of Lat/Long (circle of	$\frac{3}{12}$ Longitude: $\frac{89 \cdot 43}{72}$, $\frac{283}{77}$ me): Conventional Survey,		
Mailing Address: LOT 4	USCS and Hand hald			
foirview rd.		3 Twn Js Rng Sw		
Byholia M3 38611 City State Zip Code		Nearest Town of 5-lone woll		
Telephone No. (662) 890-5269	<u></u> Miles <u></u>	10 <u>57026661</u>		
Well / Borehole Data				
Date drilling started: $9-16-06$ Date drilling completed: $9-16-06$ Hole depth: $160'$ Hole diameter: 6314				
Location of the source of any surface water used for drilling:				
Logs run (circle all applicable). No log run Electric Gamma Ray Density Sonic Neutron Other:				
Purpose of borehole (check one): Water Well <u>C</u> Geotechnical/Geo	ogical Investigation Ground	d Source Heat Pump		
Seismic Survey Other (describe) If drilling is not related to water well construction, skip the remainder of this block				
Purpose of Well (check one): HomeIndustrial Public Supply Irrigation Fish Culture Other:				
If a flowing well, method of flow regulation: Valve \nearrow	Other (describe)			
Static Water Level: <u>45</u> feet above or below circle one) land surface Date measured: <u>$9-35-06$</u>				
Method of Measurement (circle one) steel tape electric tape air line other: String (weight				
Well depth: <u>160</u> Well grouted to a depth of <u>10</u> feet Type of grout (circle one): Neat Cement Bentonite Mix				
Casing length: 150 feet Casing diameter: 4 inches Type of casing: put				
Screen length: <u>10</u> feet Screen diameter: <u>4</u> inches Type of screen: ρ_{2}				
Screen slot size: <u>, () ()</u> inches Setting depth: From	150 feet to	(GO feet		
Type of completion (circle all applicable): Gravel packed Unde	rreamed Telescoped Oper	1 hole Natural Development		
Other (describe):	×A.			
Top of lap pipe or reduction in casing:feet. If telescoped or more than one screen, describe on next page				
		Form: OLWR-SWR-1A		


• •

DCT 16 2006 BY: OLWF

H-183

The sketch below only required for water wells


If well telescopes, show depths on sketch. Ground Level

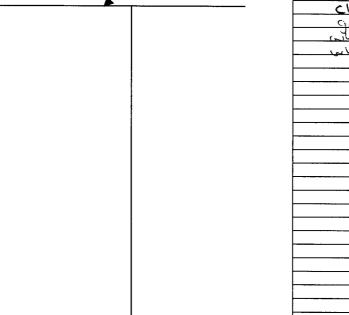

Description of formations encountered must be provided for all
wells and boreholes, unless specifically exempted by regulations

Description of Formations Encountered	From (depth)	To (depth)
clay dirt.	Ground Level	12
arciel	12	30
white socier	30	45
white soud	45	160
······································		L

If more than one screen, show location of each on sketch

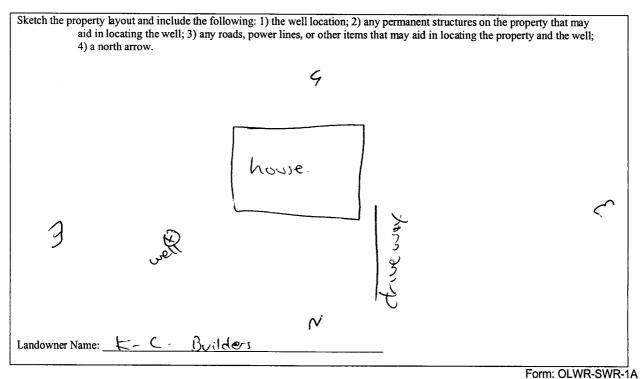

I certify that the well/borehole was drilled, constructed, and completed in accordance with all applicable requirements of the Mississippi Department of Environmental Quality and the Mississippi Department of Health regulations, if applicable, and state laws.

10-6-06

Date

Geno W Manne PECEIVED Signature of Licensee

Print Name of Responsible Licensee and License No.

0CT 18 2006 BY: OLWF

	STATE WELL REPORT	
County: Descto	Part 2 Pump Installer's Completion Report	For Office Use Only:
Permit #:	Mississippi Department of Environmental Quality	Aquifer:
Driller: Jones w. Moson	Office of Land and Water Resources P.O. Box 10631	1.00
Date completed: <u>9-25-06</u>	Jackson, MS 39289-0631 (601)961-5210	Well #: _// 3.3
Copy information from block on Part 1	(601)354-6938 (fax)	Elevation:
	- 	

,

٢

 This part of the report must be completed by a licensed water well contractor or a licensed pump installer. A copy of Part 1 of the report must be attached and both parts filed with the Department at the above address within 30 days of well completion.

 Well Owner Information
 Well Location

Owner Name: K-C Builders	Latitude: 34-51-918 Longitude: 89-43-283		
Mailing Address: Lot 4	Method of Lat/Long (check one): Conventional Survey,		
toirview rd	USGS quad, Hand-held GPS, Survey-grade GPS		
Byhelia M3 38611	SW 1/ NE 1/ Sec 33 T 25 R 5W		
City State Zip Code	Distance Direction Nearest Town		
Telephone No. (662) 290- 5369	13 H Miles NE of Stonewoll		

	Pump Type Circle one	;			Power Type Circle one	
Air Lift	Jet	Submersible		Diesel Engine	Gasoline Engine	Natural Gas
Bucket	Piston	Turbine	\langle	Electric Motor	Hand	Tractor PTO
Centrifugal	Rotary	Flowing Well		Windmill	Other (specify):	
Other (specify):				Horse Power Rating	of Motor:3/	
Date Pump Installed:	9-25-	06		Setting Depth:	70	feet
Rated Pump Capacity:	13	Gallons Per Minute		Number of Stages: _	(1	

Pump Test Data	Method of Measuring Water Level		
Date Well Tested: 9-35-06	Circle one		
	Air Line Electric Measuring Line Steel Tape		
Static Water Level (A): Feet Below Land Surface	Other (specify): String (weight		
Pumping Water Level (B): <u>~~</u> Feet Below Land Surface	oulei (specify). <u>Jin Ny Caler Jun</u>		
Drawdown [(B) - (A)]:Feet Below Land Surface	For flowing well, measured shut in head: $\cancel{\Delta}$ feet		
Test Pumping Rate: Callons Per Minute	Well yielded GPM with a drawdown of		
Duration of Pump Test (minimum 4 hours): $\underline{\partial \mathcal{H}}_{hours}$	- feet after 24 hours of pumping		

I HEREBY CERTIFY that the above statements are true to the best of	of my knowledge.	
James w. Mason 0-620	Georg Maring	
Print Name of Pump Installer and License No. (if applicable)	Signature of Pump Installer	
		Form: OFFEWED

0CT 18 2006 BY: OLWF